

Stafford

KANSAS

DX 78-1

Section 19 Township 21 Range 13W

Well No. #1 Pundsack "B"

Company Aikens & Owen

NORTH

			0				

WEST

EAST

SOUTH

Stafford

KANSAS

SEC.	TWP.	R.
19	21	13W


WELL NO. #1 Pundsack "B" FARM

COMPANY Aikens & Owen

CONTRACTOR Thunderbird Tools.

Pundsack Pool NORTH

_____ Ft. from N. Line
 990 _____ Ft. from S. Line
 330 _____ Ft. from E. Line
 _____ Ft. from W. Line

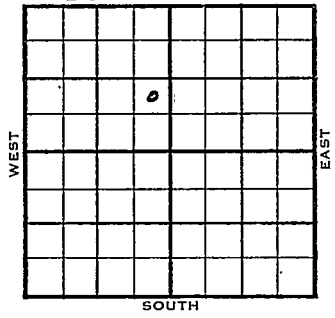

NE SE NW

	ELEVATION	REPORT
1954	1917'	

9/22

Spud 9-15-54
 8" @ 351' w/225 sks
 Anhy 807'
 Drlg. 2740'

10/6

Spud 9-15-54
 D & A
 TD 3711'
 8" @ 351'
 Anhy 807', Heeb 3240', Br. Lime 3360'
 Lans 3371'
 DST 3440'-66' opn 1 hr, rec 750' s.w.
 1050#
 DST 3486'-3540' opn 20 min, rec 10' Mud
 840# Arb. 3702
 DST 3703'-11' opn 1 1/4 hr, rec 260' s.w.
 810#
 TD 3711'
 D & A

ABANDONED

County Stafford State Kansas

Sec. 19 (Blk. 21) (Sur. 13W) (Twp. Rge.) Map No.

Operator Aikens & Owen

Well No. 1 Farm Pundsack "B"

Elev. 1917 Location NE SE NW

990 Ft. From S Line NW

330 Ft. From E Line Quarter

1st. Report

Completion OCT 6 1954

Remarks Pundsack Pool

Thunderbird - Contr.

Spudding Date 9-15-54

Drlg. Data D & A TD 3711

8" @ 351 Anhy 807 Heeb. 3240

Br. lime 3360 Lans. 3371 DST 3440-66

open 1 hr. Rec. 750' sw 1050#

DST 3486-3540 open 20 min. Rec. 10' mud

840# Arb. 3702 DST 3703-11 open 1 1/4 hr.

Rec. 260' sw 810# TD 3711

D & A

FABEN GILSTRAP