


Section 19 Township 21 Range 15W
Well No. 2 Harry Bird
Company Nadel & Gussman

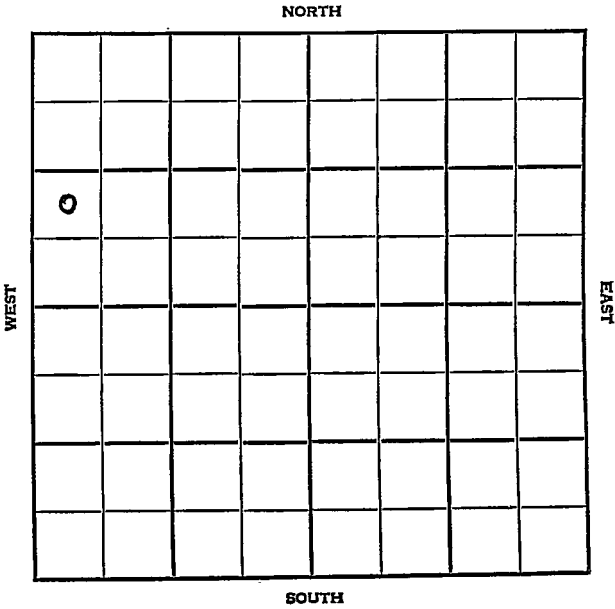

Pawnee		KANSAS
SEC.	TWP.	R.
19	21	15W
WELL NO.		
#2 Harry Bird.		FARM
COMPANY		

Nadel & Gussman

CONTRACTOR

Reserve Drlg.


Torrance Pool

_____ Ft. from N. Line

990 _____ Ft. from S. Line

_____ Ft. from E. Line

330 _____ Ft. from W. Line

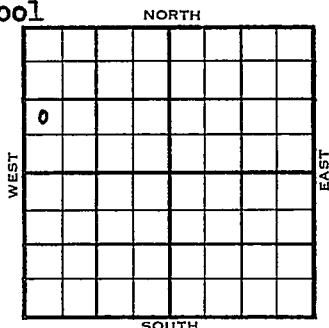


NW SW NW

	ELEVATION	REPORT
1954	1972'	
12/15	Spud 12-7-54 Anhy 944' 8" @ Drlg. 2275'	
1955 2/23	Spud 12-7-54 - Gas Well TD 3900' Anhy 944' 8" @ 944' Heeb. 3238', Br lime 3436', Lans 3445', B KC 3662', Cong. 3715', Viola 3725', Simp. 3764', Arb. 3812' DST 3813-25', opn 40", gas in 2", 1,790,000 cfg, rec. 30' wtr, 960# DST 3826-50', opn 100", gas in 2", 4,700,000 cfg, rec. 150' wtr, 1010# DST 3850-65', opn 1 hr., rec. 90' oil, 610' wtr, 1040# TD 3900' 5" @ 3892' CO 23/3847-49, F/ocw, SP 3840 24/3832-36, 7,500,000 cfg 200A Comp. 7,500,000 cfgpd	

COMPLETED

FABEN GILSTRAP

County Pawnee State Kansas
 Sec. 19 (Blk.) 21 (Sur.) 15W Map No.
 Operator Nadel & Gussman
 Well No. 2 Farm Harry Bird
 Elev. 1972 Location NW SW NW

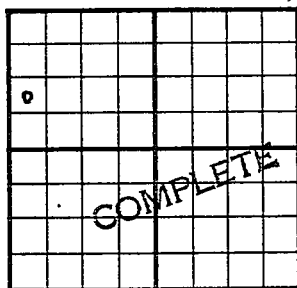

990 Ft. From S Line NW
330 Ft. From W Line Quarter
 Ist. Report
 Completion FEB 23 1955
 Remarks Torrance Pool
Reserve Drlg. - Contr.
 Spudding Date 12-7-54

Drlg. Data Gas well TD 3900
Anhy 944 8" @ 944 Heeb. 3238
Br. lime 3436 Lans. 3445 B KC 3662
Cong. 3715 Viola 3725 Simp. 3764
Arb. 3812 DST 3813-25 open 40 min.
gas in 2 min. 1,790,000 cfg Rec. 30'
wtr. 960# DST 3826-50 open 100 min.
gas in 2 min. 4,700,000 cfg Rec. 150' wtr
1010# DST 3850-65 open 1 hr. Rec.
90' oil 610' wtr. 1040# TD 3900
5" @ 3892 CO 23/ 3847-49 F/ ocw
SP 3840 24/ 3832-36 7,500,000 cfg
200 A Comp. 7,500,000 cfgpd