


KANSAS - Pawnee

FORM 51 IOM 12-46 PETROL

Section 19 Township 21 Range 15W

Well No. 1 Torrence

Company Huber et al

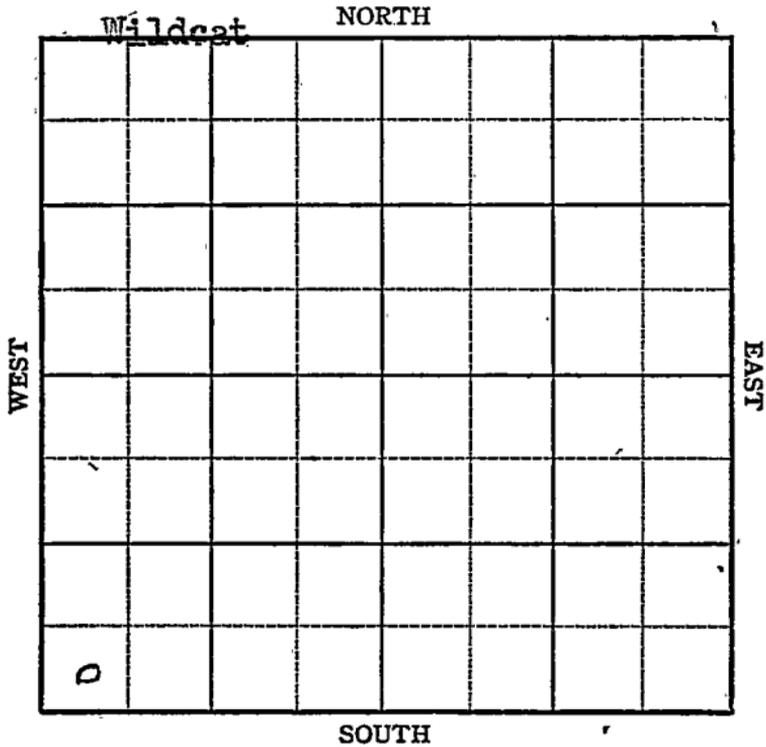

PL 2816

Sec. 19 Twp. 21 R. 15W

Well No. #1 Torrence Farm

Huber et al Company

Wildcat


 Ft. from N. Line

330 Ft. from S. Line

 Ft. from E. Line

330 Ft. from W. Line

SW/C

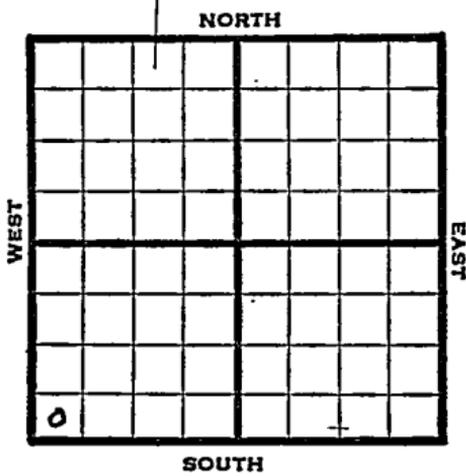

1947

Elev. 1970

REPORT

4/2

RURA

4/9

Drlg. 840'

4/15

8" @ 950'
Drlg. 3347'

4/23

Lans 3466
Cong 3751
Simp 3807'
Arb 3843'-54
TD 3854'
Gas
Run csg

4/30

Arb 3846
5" @ 3847
3000 Acid
35 M Gas
TD 3857'

COMPLETED

Map No. 82 Sec. 19 Twp. 21 R. 15W

Well No. 1 Torrence

Huber et al. Company

COMPLETE Contractor

SW/C

E. 1/1970

SECTION PLAT

_____ Ft. from N. Line

330 Ft. from S. Line

_____ Ft. from E. Line

330 Ft. from W. Line

| | | | |
|--|--|--|--|
| | | | |
| | | | |
| | | | |
| | | | |

Pawnee County

Location _____

Rig up _____

Drilling and Remarks:

See 3546
5" @ 3847
3000 acid
35M Gas

RECORD

Cased _____ in., _____ ft.

Sand _____

Gas _____

Oil _____

Total Depth 3857

PRODUCTION

1st 24 hrs. Nat. _____

1st 24 hrs. after shot _____

Gas _____ Cu. Ft.

Dry Hole _____

Abandoned _____

Date

APR 30 1947 19

S. J. LEWIS

Scout