


DX 78-1 Stafford

KANSAS
11W

Section 19 Township 21 Range 11W

Well No. #1 Smith

Company Lee Phillips

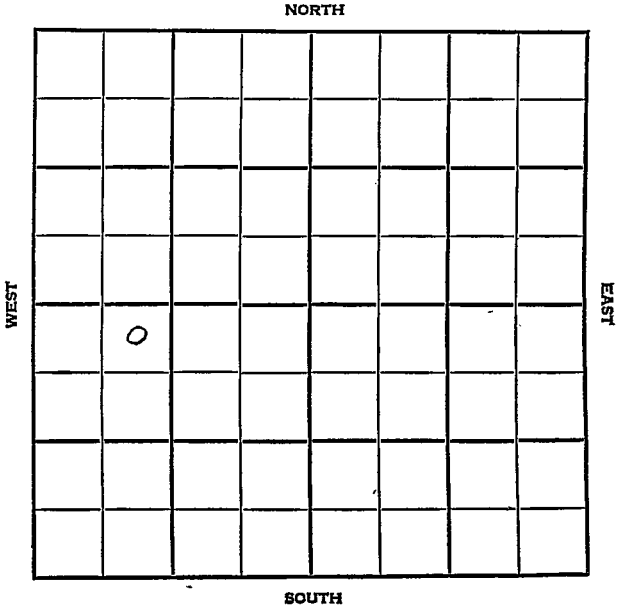

Stafford **KANSAS**

SEC. 19	TWP. 21	R. 11W
-----------------------	-----------------------	----------------------

WELL NO. **#1 Smith** FARM

COMPANY
Lee Phillips

CONTRACTOR
Harms-Burt


Sand Hills

_____ FT. FROM N. LINE

_____ FT. FROM S. LINE

_____ FT. FROM E. LINE

_____ FT. FROM W. LINE

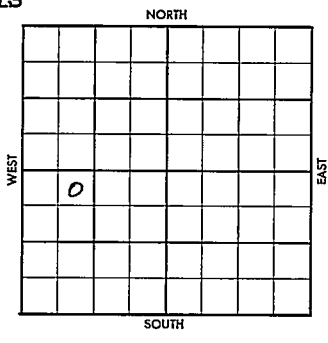

NE NW SW

	ELEVATION	REPORT
1956		
6-27	Comm. 6-22-56 8" @ 255/250 drlg. 1750	

County Stafford Elev. _____
 Sec. 19 Twp. 21 Rgs. 11W
 Company Lee Phillips
 FarmName Smith No. 1

TOPS	DEPTH	LOG	DATUM	Loc. in Sec.
Anh.	<u>551</u>			<u>NE NW SW</u>
Tp.				
H.				
Tr.				
Dg.				
Bl.				
L.				
K.C.				Geol. _____
B.K.C.				Contr. _____
Ce.				<u>Harms-Burt</u>
C.				
M.				Pool _____
M.				<u>Sand Hills</u>
K.				
Mz.				
Mo.				
V.				
S.				
S.				
A.				
R.				
PE.				
G.				
T.D.				

FIRST REPORT
 JUN 27 '56

Date Comm. 6-22-56
8" @ 255/250 drlg. 1750

22K

County Stafford Elev. 1795
 Sec. 19 Twp. 21 Rge. 11W
 Company Lee Phillips
 Farm Name Smith No. 1

TOPS	DEPTH	LOG	DATUM	Loc. in Sec.
Anb.				NE NW SW
TP.				
H.				
Tr.				
Dg.				
Bl.				
L.				Geol.
K.C.				Contr.
B.K.C.				
Ce.				
C.				
M.				Pool
M.				Sand Hills
K.				
Mz.				
Mq.				
V.				
S.				
S.				
A.				
R.				
PE.				
G.				
T.D.				

COMPLETED
 NOV 21 1985
 FIRST REFOR.

Date Comm. ADDITIONAL INFORMATION & CORRECTIONS
CO 3494 23/ 3483-87 21/ 3487-93
 Comp. 15 bopd

[Handwritten signature]

County	Stafford		Elev.	1172
Sec.	19	Twp.	21	Rge. 11W
Company	Lee Phillips			
Farm Name	Smith		No.	1

TOPS	DEPTH	LOG	DATUM	Loc. in Sec.															
Anh.	551			NE 1/4 SW															
Tp.																			
H.	3039																		
Tr.																			
Dg.																			
Bl.	3166																		
L.	3190			Geol.															
K.C.				Contr.															
B.K.C.																			
Ce.				Harms - hurt															
C.	3458			Pool															
M.				Sand hills															
M.																			
K.																			
Mz.																			
Mo.																			
V.																			
S.	3491			<table border="1"> <tr> <td colspan="3">COMPLETE</td> </tr> <tr> <td></td> <td></td> <td></td> </tr> <tr> <td></td> <td></td> <td></td> </tr> <tr> <td></td> <td></td> <td></td> </tr> <tr> <td></td> <td></td> <td></td> </tr> </table>	COMPLETE														
COMPLETE																			
S.																			
A.	3512																		
R.																			
PE.																			
G.																			
T.D.	3516			NOV 7 '56															

Date Comm. 6-22-56

8" #255/250 drl. 1750 JUL 3 '56

DST 3337-46 1hr 60' HOCM

+ 840' gas 925/20" 10' ahead

JUL 11 '56 DST 3512-16 1hr run 120'

Froggy oil 800 612 BHP 440

5 1/2 @ 3515/75 Co DD 3532

\$ 2 Boph 120/w 4 hrs 14 JUL 18 '56

\$ 2 Boph. ~~For~~ JUL 25 '56 Frac

+ 5 + 4 Boph + 6 Bwph DD 3542

AUG 1 '56 ✓ AUG 8 '56 DD 3554 +ST

4 Boph + 10 Boph

PB 3495 13481-86 +ST

1/2 Boph. nolw Frac FU

2000 oil in 14 hrs \$ 5

Boph nolw 6 hrs Pop.

AUG 15 '56
SEP 12 '56

AUG 22 '56

AUG 29 '56

SEP 5 '56

SEP 19 '56

SEP 26 '56

To rework

OCT 3 '56

Pumping

OCT 10 '56 ✓

OCT 17 '56

OCT 24 '56

PB 3490 23/3483-87

FU 7 BO + 55W Frac

6 x 6 FU 1200' oil 12

hrs nolw \$ FU 4.64

Boph 7 hrs \$ 14 BO

nolw 1 hr PB? 49/3458

-66 \$ 9.28 BO .9th hr \$

2.94 BO nolw Frac 25x3

~~CO~~ CO 3494 FUR²⁹ BO

nolw 12 hrs Plg @ 3346 47/

3331-38 A +ST V550 FU

2000' wt 24 hrs 50d. OCT 31 '56

NOV 7 '56

50d 3331-38 CO

3494 P. 35 Bopd + Tr. wt

CO P. 15 Bopd + Tr. wt