

KANSAS

FORM 51 5M BR1X

Stafford County

Section 19 Township 21 Range 11W

Well No. #1 E. F. Smith

Company Harbar Drlg. et al

NORTH

0							

SOUTH

WEST

EAST

KANSAS

Stafford County

Sec. 19 Twp. 21 R. 11W

Well No. #1 E. F. Smith Farm

Harbar Drlg. et al Company


Wildcat

 Ft. from N. Line

330 Ft. from S. Line

 Ft. from E. Line

330 Ft. from W. Line

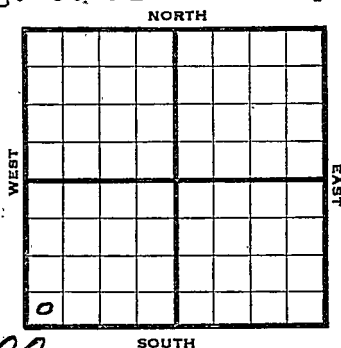

SW/c

Clear 1800

1944

R E P O R T

9/27

Location

10/4

"

10/11

Drk.

10/18

"

10/25

10" @ 280 Drlg. 1050

11/1

Anhy 565

Drig. 2715

11/8

Topeka 2785

Lans 3195

Drig. 3284

11/16

Cong 3490

Arb. 3544

Simp Sd 3515

TD 3550' S.D.

11/24

Arb 3578 corrected 5" @ 3548

TD 3554 SO

11/29

TD 3556 750 accid 100 oil

12/6

1500 accid

Swb.

5 bbls. oil per hr.

12/14

" " " "

12/21

" " " "

12/29

Temp Pot. 75.

1945

1/3

" " " "

OVER

1945

1/10

Tep Pot 75

1/17

" " "

1/24

Arb. 3548

5" @ 3548

2000 acid.

TD 3556

Pump 12 oil plus 37% water. Pot.

Grav. 38.0

COMPLETED

KANSAS


Pool Name WillcoatMap No. 46 Sec. 19 Twp. 21 R. 11WWell No. 1 E. F. SmithHarbar Drlg. etal. Company

FIRST REPORT

Contractor

SW./C

SECTION PLAT

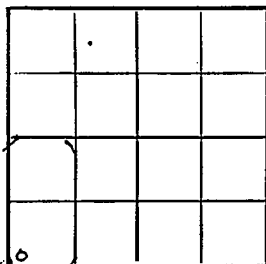

Ft. from N. Line

330 Ft. from S. Line

Ft. from E. Line

330 Ft. from W. LineStafford County

RECORD

Location X

Cased _____ in., _____ ft.

Rig up _____

Sand _____

Drilling and Remarks:

Gas _____

Oil _____

Total Depth _____

PRODUCTION

1st 24 hrs. Nat. _____

1st 24 hrs. after shot _____

Gas _____ Cu. Ft.

Dry Hole _____

Abandoned _____

Date

SEP 27 1944

19

S. J. LEWIS

Scout

Pool Name Sand HillMap No. 46 Sec. 19 Twp. 2E R. 11WWell No. 1 E. F. SmithHarbar Drig. Etal Company**COMPLETED**

Contractor

SW/c

SECTION PLAT Ft. from N. Line330 Ft. from S. Line Ft. from E. Line330 Ft. from W. Line

St efford

Location Rig up

Drilling and Remarks:

CR 3548
5" CR 3548.
2000 acid
Pump 1200 lb + 37% H₂O
P.L.T.

*38° S₂***RECORD**Cased in. ft.Sand Gas Oil Total Depth 3556**PRODUCTION**1st 24 hrs. Nat. 1st 24 hrs. after shot Gas Cu. Ft.Dry Hole Abandoned

Date

JAN 24 1945 19

S. J. LEWIS Scout