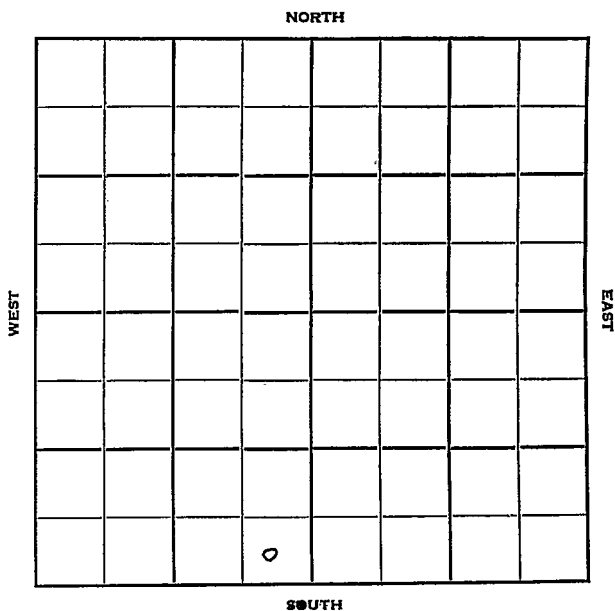


Section 19 Township 21 Range 11WWell No. 1 Smith-UnruhCompany Lindas & Omega

Stafford KANSAS

Sec. 19 Twp. 21 R. 11W

Well No. #1 Smith - Unruh Farm ☒

Lindas & Omega Company

Semi-Wildcat


 Ft. from N. Line

330' Ft. from S. Line

330' Ft. from E. Line

 Ft. from W. Line

SE SE SW

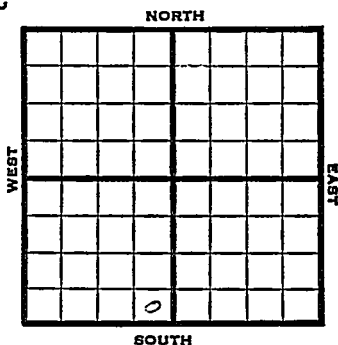

1951

Elev. 1787' REPORT

7/25

RUR

8/15

Spud 7-23-51

D&A TD 3578

8" @ 206

Anhy 538

Heeb. 3040

Br Lime 3168

Lans. 3192

DST 3459-95

opn 15 min.

Rec. 15' mud

Arb. 3531

TD 3578

D&A

ABANDONED

County Stafford State Kansas
 Sec. 19 (^{Blk.}_{Twp.}) 21 (^{Sur.}_{Rge.}) 11W Map No.
 Operator Lindas & Omega
 Well No. 1 Farm Smith - Unruh
 Elev. _____ Location SE SSW




330 Ft. From S Line SW
330 Ft. From E Line Quarter
 Ist. Report JUL 25 1951
 Completion _____
 Remarks Stanolind DEM
 Spudding Date _____

Drlg. Data Semi Wildcat

R U R

J. E. TYRA

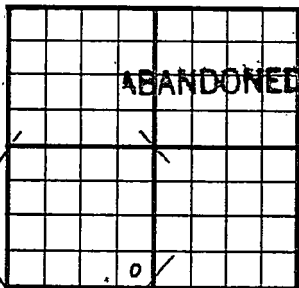County Stafford State KansasSec. 19 (Blk.) 21 (Sur.) 11W Map No.Operator Lindas & OmegaWell No. 1 Farm Smith - UnruhElev. 1787 Location SE SE SW330 Ft. From S Line SW330 Ft. From E Line Quarter

1st. Report

Completion AUG 15 1951Remarks Semi WildcatSpudding Date 7-23-51Drilg. Data D & A TD 35788" @ 206 Anhy 538 Heeb. 3040Br. lime 3168 Lans. 3192 DST 3459-95open 15 min. Rec. 15' mud Arb. 3531TD 3578 D & A

J. E. TYRA