

Stafford


KANSAS

SECTION 19 TOWNSHIP 21 RANGE 11 W

WELL NO. #1 Smith Est.

COMPANY Republic Natural

NORTH

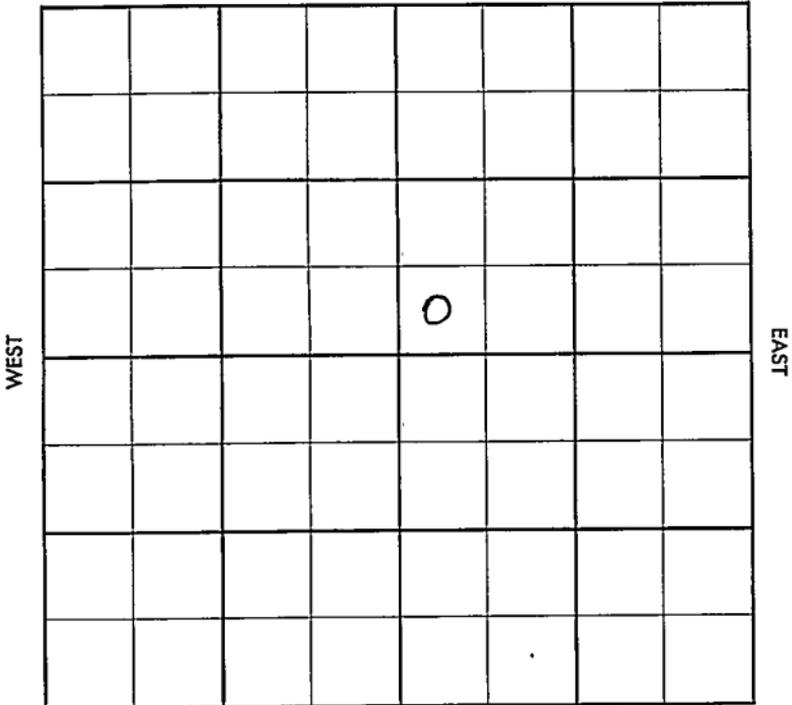

SOUTH

Stafford

KANSAS

SEC. 19	TWP. 21	R. 11W
------------	------------	-----------

WELL NO.

#1 Smith Est.

FARM

COMPANY

Republic Natural

CONTRACTOR

Isern Drlg.

Sand Hills


NORTH

\_\_\_\_\_ Ft. from N. Line

\_\_\_\_\_ Ft. from S. Line

\_\_\_\_\_ Ft. from E. Line

\_\_\_\_\_ Ft. from W. Line

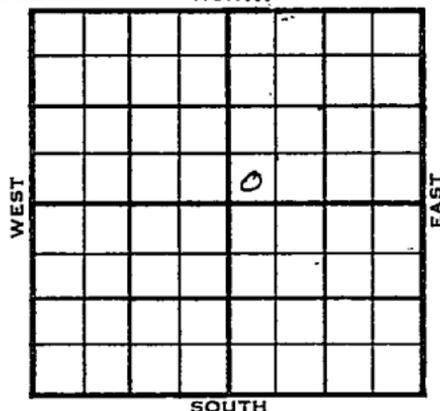~~###~~ SW SW NE

1955	ELEVATION 1787 DF, 1789 <del>RE</del> REPORT
------	---

12-21	Comm. 12-14-55 10" @ 234/175 Drlg. 2010 Anh. 550'
-------	--

1956 1-5	DST 3189-3217 op $\frac{1}{2}$ hr. rec. 7' mud, 0# DST 3242- <del>66</del> op $\frac{1}{2}$ hr. rec 12' mud 0# DST 3330-61 op 35 min. rec. 25' mud, 0/30" DST 3418-53 op 1 hr. rec. 280' sw, <del>##</del> 975/30" D & A Tp. 2745 H. 3036 Tr. 3055 Dg. 3069 BL. 3162 L: <del>###</del> 3186 C. 3427 V. 3499 S. 3535 A. 3565 TD 3620
-------------	--

ABANDONED

County Stafford Elev. \_\_\_\_\_  
 Sec. 19 Twp. 21 Rge. 11W  
 Company Republic Natural  
 Farm Name Smith Est. No. 1

TOPS	DEPTH	LOG	DATUM
Anh.	<u>550</u>		
Tp.			
H.			
Tr.			
Dg.			
Bl.			
L.			
K.C.			
B.K.C.			
Ce.			
C.			
M.			
M.			
K.			
Mz.			
Me.			
V.			
S.			
S.			
A.			
R.			
Pe.			
G.			
T.P.			

Loc. in Sec. SW SW NE  
 Geol. \_\_\_\_\_  
 Contr. Isern Drle.  
 Pool Sand Hills

FIRST REPORT  
 DEC 21 1955

Date Comm. 12-14-55  
10" @ 234/175 drlg. 2010

*[Handwritten signature]*

Co.  
 Lse.  
 No.  
 Sec.  
 T.  
 R.

1787 DF

1789 KB

County Stafford

Elev.

Sec. 19 Twp. 21 Rge. 11WCompany Republic NaturalFarmName Smith Est. No. 1

TOPS	DEPTH	LOG	DATUM	Loc. in Sec.
Anh.	550			SW SW NE
TP.	2745		956	
H.	3056		1247	
Tr.	3055		1266	
Dg.	3069		1280	
BL.	3162		1373	
L.	3186		1397	
K.C.				Geol.
B.K.C.				Contr.
Ce.				
C.	3427		1638	Isern Drlg.
M.				Pool
M.				
K.				
Mz.				Sand Hills
Me.				
V.	3499		1710	
S.	3536		1747	
S.				
A.	3565		1776	
R.				
PE.				
G.				ABANDONED
TP.	3620			

Date Comm. 12-14-55 JAN 5 195610" @ 234/175 DST 3189-3217 open  $\frac{1}{2}$  hr.rec. 7' mud 0# DST 3242-66 open  $\frac{1}{2}$  hr.

rec. 12' mud 0# DST 3330-61 open

35 min. rec. 25' mud 0/30" DST 3418-

53 open 1 hr. rec. 280' sw 975/30"

D &amp; A