


KANSAS

Section 2 Township 21 Range 13-W
 Well No. #1 Address "B"
 Company M B Armer & N C R A Holme

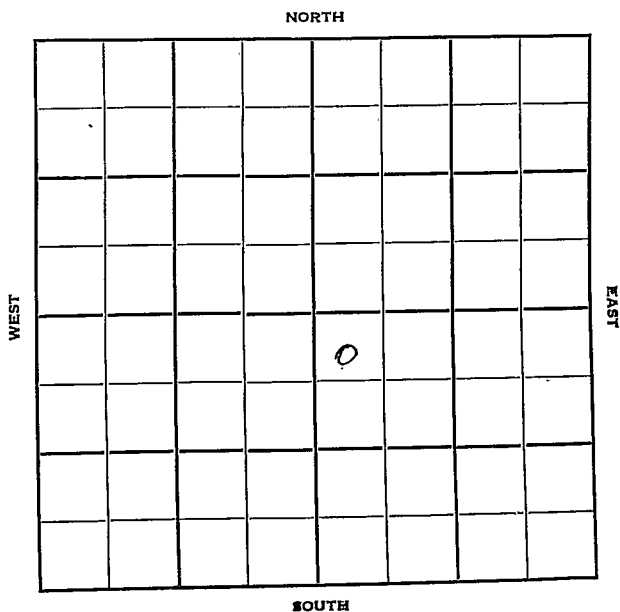

KANSAS

Stafford, ✓

Sec. 2 Twp. 21 R. 13W

Well No. #1 2 Andrews "B" Farm

M.B. Armer & N C R A Company
Armer Contr. Holme Pool


330 Ft. from N. Line

 Ft. from S. Line

 Ft. from E. Line

330 Ft. from W. Line

NW SE

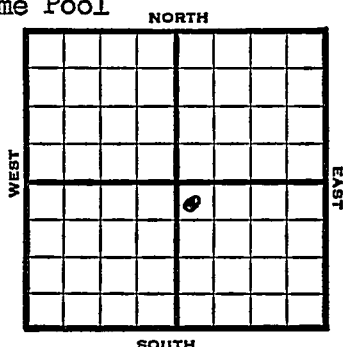

1949 Lev 1870' REPORT

7/27	Location
8/3	8" @ 185'
	Drlg 2890'
8/10	Lansing 3250'
	Arb. 3524'
	TD 3528'
	5" @ 3524'
8/17	TD 3529'
	1000 acid
8/24	"
8/31	"
9/7	"
9/14	"
9/21	"
9/28	TD 3529'
	Arb. 3524'
	5" @ 3524'
	1000 acid
	Pump 41 Oil / 51 % W Pot
	39° Gr.
	Gomp

COMPLETED

Kansas

Holme Pool

Map No. _____ Sec. 2 Twp. 21 R. 13WWell No. 2 Address _____M. B. Armer & N C R A Company

Armer

Contractor

NW SE

FIRST REPORT
SECTION PLAT330 Ft. from N. Line

_____ Ft. from S. Line

_____ Ft. from E. Line

330 Ft. from W. Line

. Stafford County

Location ✓

Rig up _____

Drilling and Remarks _____

RECORD

Cased _____ in., _____ ft.

Sand _____

Gas _____

Oil _____

Total Depth _____

PRODUCTION

1st 24 hrs. Nat. _____

1st 24 hrs. after shot _____

Gas _____ Cu. Ft.

Dry Hole _____

Abandoned _____

Date

JUL 27 1949 19

S. J. LEWIS

Scout

Kansas

Map No. _____ Sec. 2 Twp. 21 R. 13W

Well No. 1 Address "B"


M. B. Armer

Company

CORRECTION

Contractor

NW SE

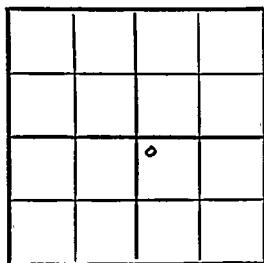SECTION PLAT

330 Ft. from N. Line

_____ Ft. from S. Line

330 Ft. from E. Line

_____ Ft. from W. Line

Stafford County

RECORD

Location _____

Cased _____ in., _____ ft.

Rig up _____

Sand _____

Drilling and Remarks:

Gas _____

Reported

Oil _____

#2 Address

Total Depth _____

PRODUCTION

1st 24 hrs. Nat. _____

1st 24 hrs. after shot _____

Gas _____ Cu. Ft.

Dry Hole _____

Abandoned _____

Date

AUG 10 1949 19

S. J. LEWIS Scout

Kansas

Map No. _____ Sec. 2 Twp. 21 R. 13WWell No. 1 Address "B"

M. B. Armer & NCRA

Company

COMPLETE

Contractor


NW SE

E11870
SECTION PLAT330 Ft. from N. Line

_____ Ft. from S. Line

330 Ft. from E. Line

_____ Ft. from W. Line

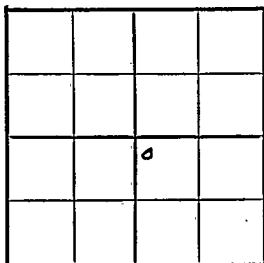

Stafford County

RECORD

Location _____

Cased _____ in., _____ ft.

Rig up _____

Sand _____

Drilling and Remarks:

Gas _____

Oil _____

Total Depth 3525

PRODUCTION

1st 24 hrs. Nat. _____

1st 24 hrs. after shot _____

Gas _____ Cu. Ft.

Dry Hole _____

Abandoned _____

Date

SEP 28 1949 19

S. J. LEWIS Scout