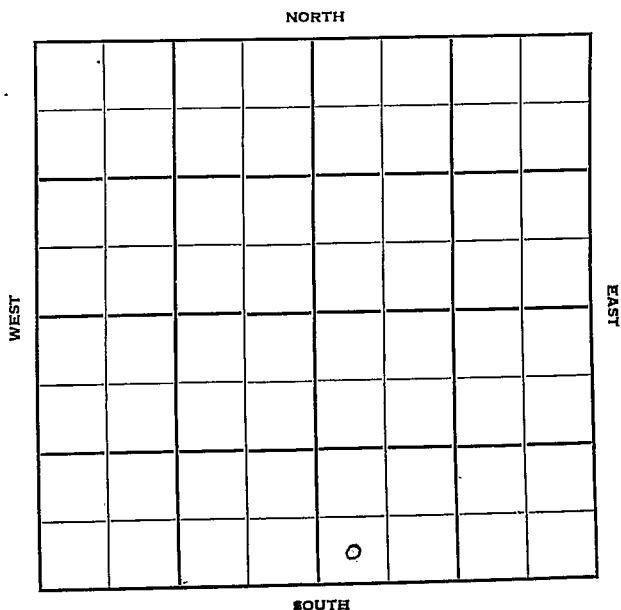


Section 2 Township 21- Range 15-WWell No. #1 DammCompany Vickers Petroleum

Pawnee

KANSAS

Sec. 2 Twp. 21 R. 15W

Well No. #1 Damm Farm

Vickers Petr. Company

Wildcat


Ft. from N. Line

330' Ft. from S. Line

Ft. from E. Line

330' Ft. from W. Line

SW SW SE

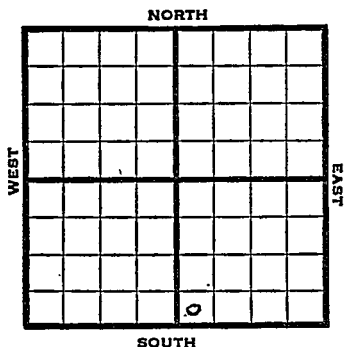

1950

Elev. 1931' REPORT

9/6

Spud 9-3-50
8-5/8" @ 894'
WOC

9/20

Spudding 9-3-50
D&A TD 3830'
8-5/8" @ 894'
Heeb 3287' Br. Lime 3390'
Lans. 3400' Cong. 3680'
Arb 3813' TD 3830'

ABANDONED



Operator Tickers Petroleum

Well No. 7 Farm ~~Diamond~~

Elev.	Location	SW	SE	SE
-------	----------	----	----	----

0

330 Ft. From S Line SE

330 Ft. From **W** Line Quarter

1st. Report SEP 6 1950

Completion

Remarks

Stanolind DEM


Spudding Date **9-3-50**

Drig. Data Wildcat

8 5/8" @ 894 WOC

J. E. TYRA

County Pawnee State Kansas
 Sec. 2 (Blk. 21) (Sur. 15W) Map No.
 Operator Vickers Petroleum
 Well No. 1 Farm Damm
 Elev. 1931 Location SW SW SE

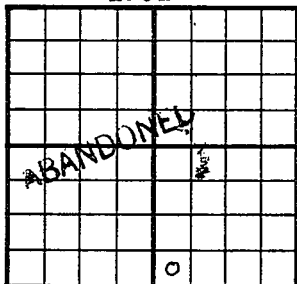

330 Ft. From S Line SE
330 Ft. From W Line Quarter
 Ist. Report ~~SEP 20 1950~~
 Completion SEP 20 1950
 Remarks Wildcat
 Spudding Date 9-3-50

Drlg. Data D & A TD 3830
8 5/8" @ 894 Heeb. 3287 Br. lime 3390
Cans. 3400 Cong. 3680 Arb. 3813
TD 3830 D & A

J. E. TYRA