Rice KANSAS

SECTION 2 TOWNSHIP 21S RANGE 8W

WELL NO. #1 Galen Gibson

COMPANY Skelly Oil

NORTH NE SW SW

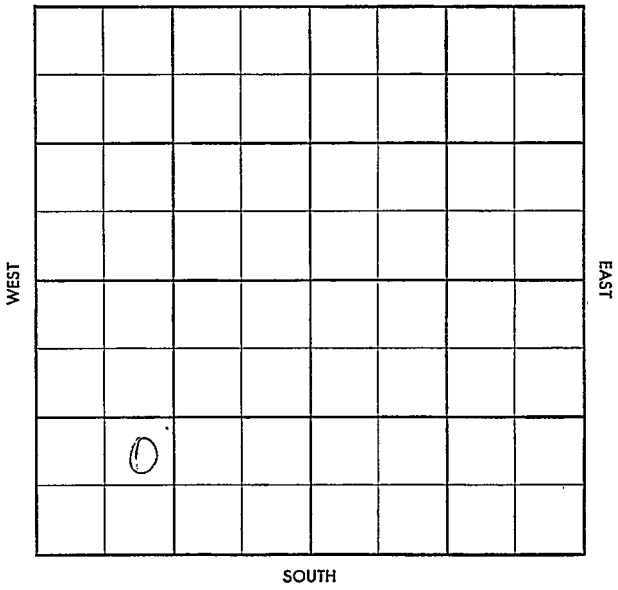

S-513-A

CO. Rice ELEV. FIRST REPORT

SEC. 2 TWP. 21 RGE. 8W

COMPANY Skelly Oil NO. 1

SDX

DEC 11 '47

FARM Galen Gibson

LOC. NE SW SW

GEOL.

CONTR.

POOL Wherry

SPUD

Location

CO. LSE. NO. SEC. TWP. RGE.

S-513-A

CO [illegible] ELEV. 16420

[redacted] 2 TWP 21 RGE. 8W

[redacted] NO. 1

SDX 3/8 mile

JAN 8 '58

ABANDONED

FARM Galen Gibson

LOC. [illegible] SW SW

H 2747	
BL 2893	
L 2922	
BKC 3233	
M 3313	
TD 3485	

GEOL.

CONTR. Wentworth

POOL Wherry

SPUD 12-18-57

Locatio [illegible] DEC 26 '57

anh 265 8"

284/250 Ø 2060

JAN 2 '58 Ø 3290

JAN 8 '58 DST 3285

- 3305 60" 10' DM

BHP 0/30 DST ~~3[illegible]~~

3297 - 3337 60" 68' DM

BHP 100/30"

D & A

CO. LSE. NO. SEC. TWP. RGE.

This well was First Reported in
Section #2 and Completed in Sec. 3.
Please advise which is corredt.

Thanks,
Sam Baird