

Section 2 Township 21 Range 11W

Well No. 1 Rugan

Company Ingling et al

Wildcat

NORTH

WEST

EAST

|  |  |  |  |  |  |  |  |
|--|--|--|--|--|--|--|--|
|  |  |  |  |  |  |  |  |
|  |  |  |  |  |  |  |  |
0

SOUTH

KANSAS

Stafford



Sec. 2 Twp. 21 R. 11W

Well No. #1 Rugan Farm

Ingling et al

Company

Wildcat

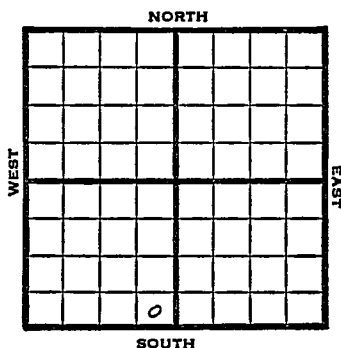
           Ft. from N. Line

330' Ft. from S. Line

330' Ft. from E. Line

           Ft. from W. Line

SE SW



1949

Ebi 1752'

R E P O R T

1/5

8" @ 312'

1/12

Dr1g 2640

1/19

TD3496'

Lans. 3079'

Arb 3470'

Aband.

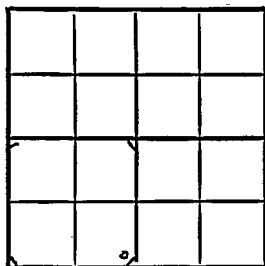
**ABANDONED**

Kansas

Wildcat

Map No. \_\_\_\_\_ Sec. 2 Twp. 21 R. 11WWell No. 1 RuganIngling et al. Company**FIRST REPORT** Contractor

SE SW

**SECTION PLAT**

\_\_\_\_\_ Ft. from N. Line

330

\_\_\_\_\_ Ft. from S. Line

330

\_\_\_\_\_ Ft. from E. Line

\_\_\_\_\_ Ft. from W. Line

Stafford County

Location \_\_\_\_\_

Rig up \_\_\_\_\_

Drilling and Remarks: \_\_\_\_\_

8" @ 312

**RECORD**

Cased \_\_\_\_\_ in., \_\_\_\_\_ ft.

Sand \_\_\_\_\_

Gas \_\_\_\_\_

Oil \_\_\_\_\_

Total Depth \_\_\_\_\_

**PRODUCTION**

1st 24 hrs. Nat. \_\_\_\_\_

1st 24 hrs. after shot \_\_\_\_\_

Gas \_\_\_\_\_ Cu. Ft.

Dry Hole \_\_\_\_\_

Abandoned \_\_\_\_\_

Date

JAN 5 1949

19

S. J. LEWIS

Scout

Kansas

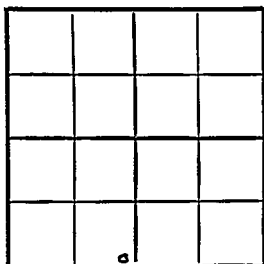
Map No. 46 Sec. 2 Twp. 21 R. 11WWell No. 1 RuganIngling et al.

Company

**ABANDONED**

Contractor

SE SW

E 11752  
**SECTION PLAT**       Ft. from N. Line330 Ft. from S. Line330 Ft. from E. Line       Ft. from W. LineStafford CountyLocation                     Rig up                     

Drilling and Remarks:

Lane 3079CR 3470**RECORD**Cased            in.,            ft.Sand                                     Gas                                     Oil                                     Total Depth 3496**PRODUCTION**1st 24 hrs. Nat.                     1st 24 hrs. after shot                     Gas                      Cu. Ft.Dry Hole                     Abandoned                     

Date

JAN 1 9 1949

19

S. J. LEWIS

Scout