FORM 51 25M 3-49 PETROL


Stafford KANSAS

Section 2 Township 21 Range 11W

Well No. #1 Estabrook

Company Keyes Drlg.

Wildcat

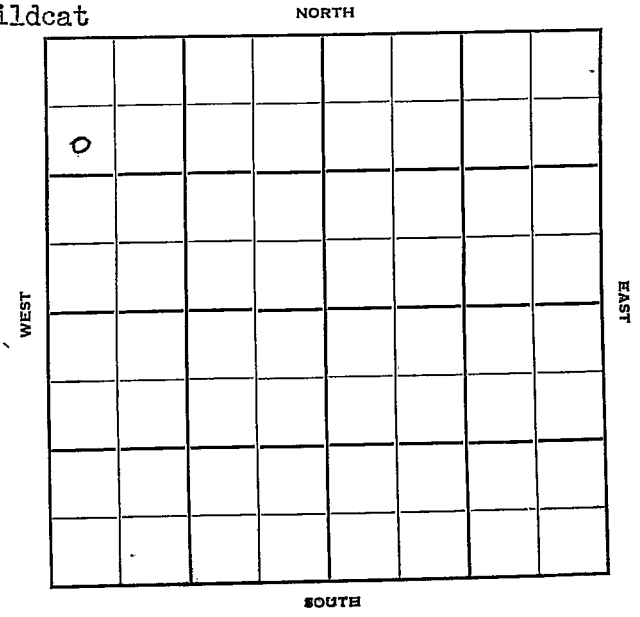

FORM 252-A
5M 10-48 PETROL

Stafford KANSAS

Sec. 2 Twp. 21 R. 11W

Well No. #1 Estabrook Farm

Keyes Drlg. Company

Wildcat (Keyes, Contr.)


990' Ft. from N. Line

_____ Ft. from S. Line

_____ Ft. from E. Line

330' Ft. from W. Line

SW NW NW

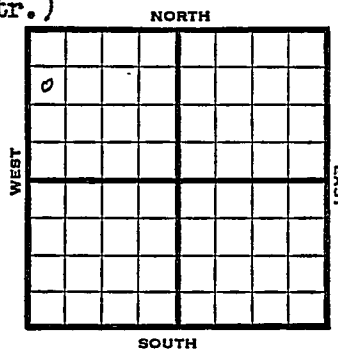

1949	Elev. 1771' REPORT
12/14	Surface Hole
12/28	Arb. 3365' TD 3388' ABANDONED

Form 26 200 Bks. 6-49 Petrol

Wildcat

Kansas

Map No. ____ Sec. 2 Twp. 21 R. 11W

Well No. 1 Estabrook


Keyes Drlg. Company

Keyes Drlg. Contractor

SW NW NW

FIRST REPORT

SECTION PLAT

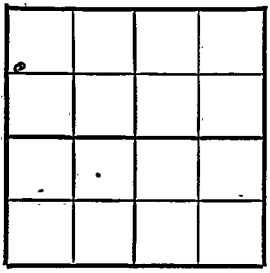

990 Ft. from N. Line

____ Ft. from S. Line

____ Ft. from E. Line

330 Ft. from W. Line

Stafford County

Location ____

Rig up ____

Drilling and Remarks:

surface hole

RECORD

Cased ____ in., ____ ft.

Sand ____

Gas ____

Oil ____

Total Depth ____

PRODUCTION

1st 24 hrs. Nat. ____

1st 24 hrs. after shot ____

Gas ____ Cu. Ft.

Dry Hole ____

Abandoned ____

Date

DEC 14 1949 19

S. J. LEWIS Scout

Form 26 200 Bks. 6-49 Petrol

Wildcat

Kansas

Map No. _____ Sec. 2 Twp. 21 R. 11W

Well No. 1 Estabrook


Keyes Drlg. Company

ABANDONED Contractor

SW NW NW

E/1791

SECTION PLAT

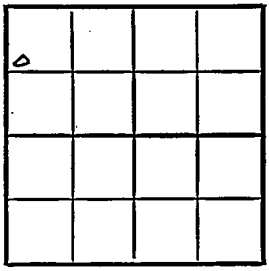

990 Ft. from N. Line

_____ Ft. from S. Line

_____ Ft. from E. Line

330 Ft. from W. Line

Stafford County

Location _____

Rig up _____

Drilling and Remarks:

RTD 3365

RECORD

Cased _____ in., _____ ft.

Sand _____

Gas _____

Oil _____

Total Depth 3388

PRODUCTION

1st 24 hrs. Nat. _____

1st 24 hrs. after shot _____

Gas _____ Cu. Ft.

Dry Hole _____

Abandoned _____

Date

DEC 28 1949 19

S. J. LEWIS Scout