


Stafford **KANSAS**

Section 2 Township 21 Range 12W

Well No. #1 Hewitt

Company Lotus Oil

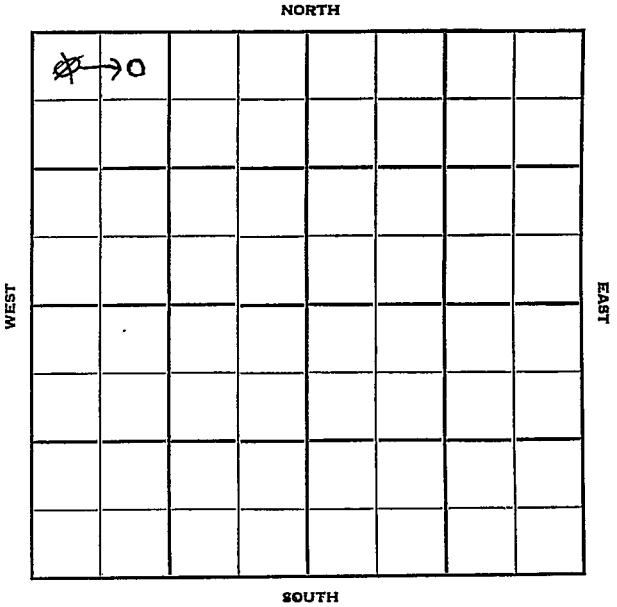

Stafford

Sec. 2 Twp. 21 R. 12W

Well No. #1 Hewitt Farm

Lotus Oil Company

L. Hilton Contractor

Bryant


330 Ft. from N. Line

_____ Ft. from S. Line

_____ Ft. from E. Line

330 Ft. from W. Line

NW NW NW

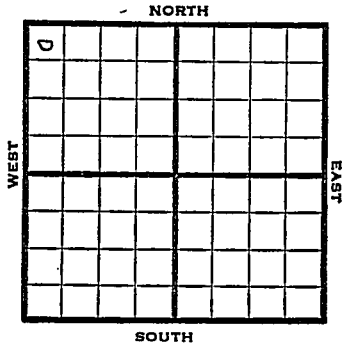

Eldorado-FO

1951

Elev. 1840'

REPORT

10/31

Location

1952
1/16

Oil well TD 3436' Heeb 3043'
 Br. line 3174' Lans. 3188'
 Arb. 3426'
 DST 3428-36 open 1 hr. rec 150' HOCM
 & 540' oil, 5" @ 3428' CO to 3436
 FU 2550' oil 19 hr.
 Comp. 149 BOPD

COMPLETED

County Stafford State Kansas

Sec. 2 (Blk. 21) (Sur. 12W) (Twp. 21) (Rge. 12W) Map No.

Operator Lotus Oil

Well No. 1 Farm Hewitt

Elev. _____ Location NW NW NW

0					

FIRST REPORT

330 Ft. From N Line NW

330 Ft. From W Line Quarter

Ist. Report OCT 31 1951

Completion _____

Remarks Eldorado - FO

Hilton - Contr.

Spudding Date _____

Drlg. Data Bryant

Location

J. E. TYRA

Kansas

Map No. _____ Sec. 2 Twp. 21 R. 12W

Well No. 2 Hewitt

Lotus Oil Company

~~CORRECTION~~

Contractor

NE NW NW

SECTION PLAT

330 Ft. from N. Line

_____ Ft. from S. Line

_____ Ft. from E. Line

990 Ft. from W. Line

0			

Stafford County

Location _____

Rig up _____

Drilling and Remarks:

Reported

NW NE NW

RECORD

Cased _____ in., _____ ft.

Sand _____

Gas _____

Oil _____

Total Depth _____

PRODUCTION

1st 24 hrs. Nat. _____

1st 24 hrs. after shot _____

Gas _____ Cu. Ft.

Dry Hole _____

Abandoned _____

Date

DEC 1 2 1951

19 _____

J. E. TYRA

Scout

County Stafford State Kansas

Sec. 2 (Blk.) 21 (Sur.) 12W Map No.

Operator Lotus Oil

Well No. 1 Farm Hewitt

Elev. 1840 Location NW NW NW

0					

COMPLETE

330 Ft. From N Line NW

330 Ft. From W Line Quarter

Ist. Report

Completion JAN 16 1957

Remarks Bryant Pool

Hilton - Contr.

Spudding Date

Drlg. Data Oil well TD 3436

Heeb. 3043 Br. lime 3174 Lans. 3188

Arb. 3426 DST 3428-36 open 1 hr.

Rec. 150' hocm & 540' oil 5" @ 3428

CO to 3436 FU 2550' oil 19 hr.

Comp. 149 bopd