

KANSAS


Section 2 Township 21S Range 12W

Well No. #1 Robl

Company Bay Pet. Co.

Wildcat

NORTH

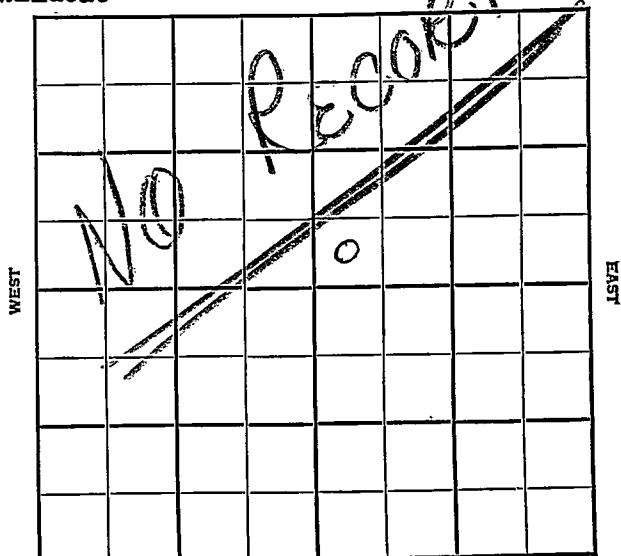


SOUTH

Stafford County Kansas StateMap No. 46 Sec. 2 Twp. 21 R. 12WWell No. 1 RoblBay Pet. CompanyNo-Record Contractor

SW NE

SECTION PLAT

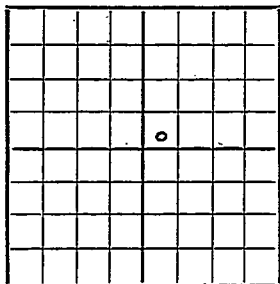 Ft. from N. Line330 Ft. from S. Line Ft. from E. Line330 Ft. from W. LineWildcat

Remarks:

Abandoned on June 9, 1948 as #2 Robl

Date
AUG 4 1948

Scout S. J. LEWIS