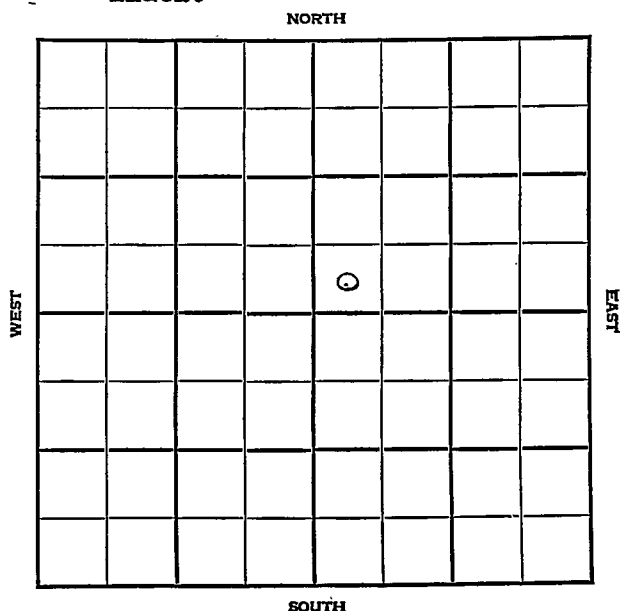


KANSAS

Stafford

Section 2 Township 21 Range 12-WWell No. #2 RoblCompany Bay Pet.
Wildcat

KANSAS

Stafford

Sec. 2 Twp. 21 R. 12W

Well No. #2 Robl Farm

Bay Pet. Company

Wildcat


 Ft. from N. Line

330' Ft. from S. Line

 Ft. from E. Line

330' Ft. from W. Line

SW NE

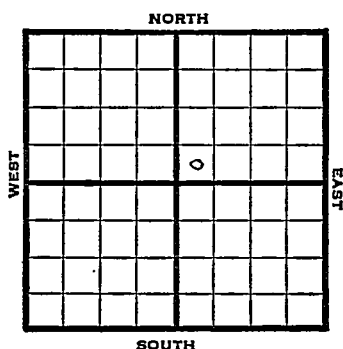

1948 Elev. 1830' REPORT

5/26 RUR

6/1 8" @ 315'
Drlg. 1760'

6/9 Viola 3411'
Simp. 3434'
Arb. 3472'
TD 3512'
Abd.

ABANDONED

Map No. _____ Sec. 2 Twp. 21 R. 12W

Well No. 2 Robl


Bay Pet. _____ Company _____

FIRST REPORT

Contractor _____

SW NE

SECTION PLAT

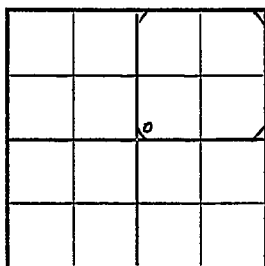

_____ Ft. from N. Line

330 Ft. from S. Line

_____ Ft. from E. Line

330 Ft. from W. Line

Stafford County

Location _____

Rig up _____

Drilling and Remarks:

R U R

RECORD

Cased _____ in., _____ ft.

Sand _____

Gas _____

Oil _____

Total Depth _____

PRODUCTION

1st 24 hrs. Nat. _____

1st 24 hrs. after shot _____

Gas _____ Cu. Ft.

Dry Hole _____

Abandoned _____

Date

MAY 26 1948 19 S. J. LEWIS Scout

Map No. 46 Sec. 2 Twp. 2E R. 12W

Well No. 2 Robl

Bay Pet. Company

ABANDONED

Contractor

SW NE

E. 1800

SECTION PLAT

		0	

 Ft. from N. Line

330 Ft. from S. Line

 Ft. from E. Line

330 Ft. from W. Line

Stafford County

Location

Rig up

Drilling and Remarks:


RECORD

Cased in., ft.

Sand

Gas

Oil

Total Depth 3512

PRODUCTION

1st 24 hrs. Nat.

1st 24 hrs. after shot

Gas Cu. Ft.

Dry Hole

Abandoned

Date

JUN 9 1948 19

S. J. LEWIS Scout