

KANSAS


Stafford

FORM 51 5M 10-41 PETROL

Section 20 Township 21-- Range 13-W

Well No. #1 Franschier

Company W. P. Faulkner etal.

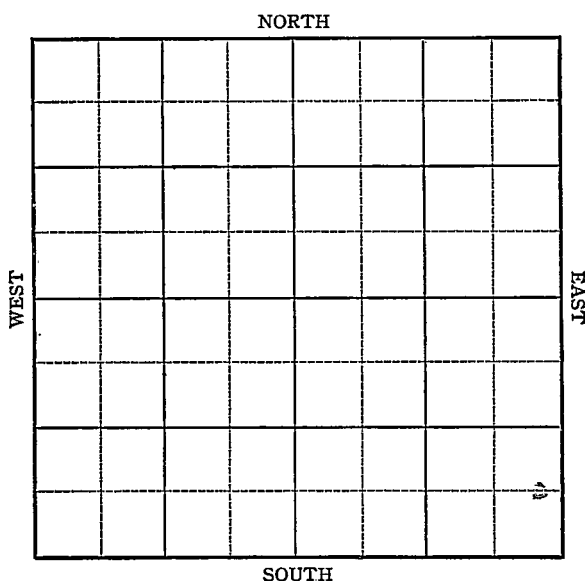

KANSAS Stafford

Sec. 20 Twp. 21 R. 13-W

Well No. #1 Fanshier Farm

W. P. Faulkner et al Company

Hazel Pool


 Ft. from N. Line

660 Ft. from S. Line

330 Ft. from E. Line

 Ft. from W. Line

Elev. 1933

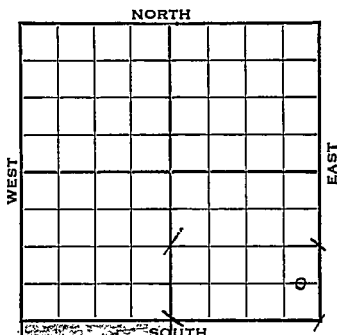

1942

REPORT

12/16

Rotary

12/22

10" @ 220' WOC

12/29

" "

1943

1/6

Lans. 3409

Congl 3668 --

3796 in Congl - no shows

T.D. 3796

ABANDONED

Stafford

KANSAS
 Map No. 82 Sec. 20 Twp. 21 R. 13W


Well No. 1 Fanschier

W. P. Faulkner et al. Company

FIRST REPORT Contractor

C E L S E S E

SECTION PLAT

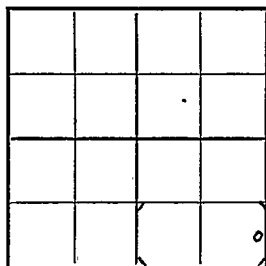 Ft. from N. Line660 Ft. from S. Line330 Ft. from E. Line Ft. from W. Line

HAZEL POOL

Location Rig up

Drilling and Remarks:

Rotary

RECORD

M.P.C.

Cased in., ft.Sand Gas Oil Total Depth

PRODUCTION

1st 24 hrs. Nat. 1st 24 hrs. after shot Gas Cu. Ft.Dry Hole Abandoned

Date

DEC 16 1942

19

S. J. LEWIS

Scout

KANSASMap No. 22 Sec. 20 Twp. 21 R. 13WWell No. 1 FanschierW. P. Faulkner et al. CompanyABANDONED Contractor

C E L S E S E

SECTION PLAT

			0

 Ft. from N. Line660 Ft. from S. Line330 Ft. from E. Line Ft. from W. LineHAZEL POOLLocation Rig up

Drilling and Remarks:

*Home 3408**Congl 3668**3796 in Congl**No show*

RECORD

Cased in., ft.Sand Gas Oil Total Depth 3796

PRODUCTION

1st 24 hrs. Nat. 1st 24 hrs. after shot Gas Cu. Ft.Dry Hole Abandoned

Date

JAN 6 1943 19S. J. LEWIS

Scout