

Stafford

FORM 51 25M 3-49 PETROL

KANAS

Section 20 Township 21 Range 13W

Well No. #1 Koopman

Company Petroleum, Inc.

Wildcat

NORTH

WEST

EAST

					0		

SOUTH

Sec. 20 Twp. 21 R. 13W

Well No. #1 Koopman Farm

Petroleum, Inc. Company


Wildcat (Stag, Contr.) **NORTH**

330' Ft. from N. Line

_____ Ft. from S. Line

_____ Ft. from E. Line

990' Ft. from W. Line

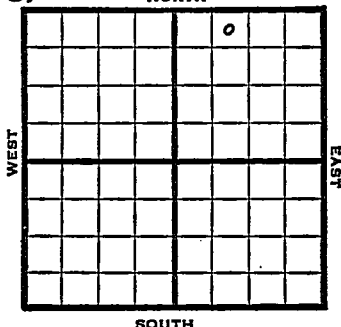

NE NW NE

SOUTH

1949 Elev 1902' **REPORT**

12/7 8" @ 303'
Anhy 795'
Drlg. 1880'

12/14 Lansing 3344'
Drlg. 3526'

12/21 Viola 3590'
Simpson 3619'
Arbuckler 3673'
5" @ 3674'
TD 3679'

12/28 "

1950

3/29 TD 3679'
8" @ 303'
5" @ 3674'
Lans 3344'
Viola 3590'
Simp 3619'
Arb. 3673'
311 BOPD
Comp

COMPLETED

Kansas

Wildcat

Map No. _____ Sec. 20 Twp. 21 R. 13W

Well No. 1 Koopman

_____ Petroleum Inc. _____ Company

_____ Stag _____ Contractor

NE NW NE

FIRST REPORT
SECTION PLAT

330 Ft. from N. Line

_____ Ft. from S. Line

_____ Ft. from E. Line

990 Ft. from W. Line

		0	

Stafford County

Location _____

Rig up _____

Drilling and Remarks:

8" @ 303

Anhy 795

drlg. 1880

RECORD

Cased _____ in., _____ ft.

Sand _____

Gas _____

Oil _____

Total Depth _____

PRODUCTION

1st 24 hrs. Nat. _____

1st 24 hrs. after shot _____

Gas _____ Cu. Ft.

Dry Hole _____

Abandoned _____

Date

DEC 7 1949


19

S. J. LEWIS

Scout

Map No. _____ Sec. 20 Twp. 21 R. 13WWell No. 1 Koopman_____
Petroleum Inc. _____ Company_____
Contractor

NE NW NE

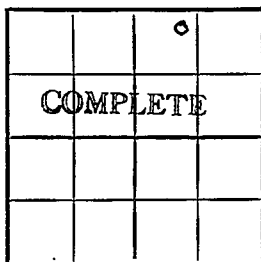El. 1902
SECTION PLAT330 Ft. from N. Line_____
Ft. from S. Line_____
Ft. from E. Line990 Ft. from W. Line

Stafford County

Location _____

Rig up _____

Drilling and Remarks:

*8" @ 303**5" @ 3674**Lane 3344**Viola 3596**Simp 3619**arb 3673**311 BOPD*

RECORD

Cased _____ in., _____ ft.

Sand _____

Gas _____

Oil _____

Total Depth 3679

PRODUCTION

1st 24 hrs. Nat. _____

1st 24 hrs. after shot _____

Gas _____ Cu. Ft.

Dry Hole _____

Abandoned _____

Date

MAR 29 1950

19

J. E. TYRA Scout