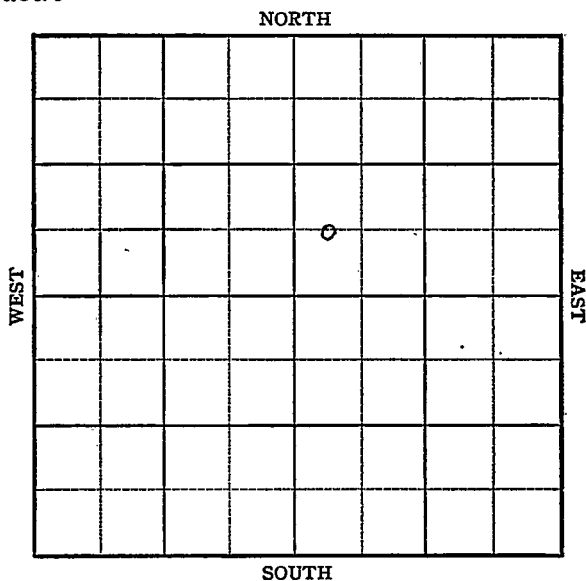


Section 20 Township 21 Range 13WWell No. #1 PurselCompany Petroleum, Inc.
Wildcat

Stafford

KANSAS

Sec. 20 Twp. 21 R. 13W

Well No. #1 Pursel Farm

Petroleum, Inc.

Company

Wildcat (Stag Drlg, Contr.)

NORTH

Ft. from N. Line


660'

Ft. from S. Line

Ft. from E. Line

330'

Ft. from W. Line

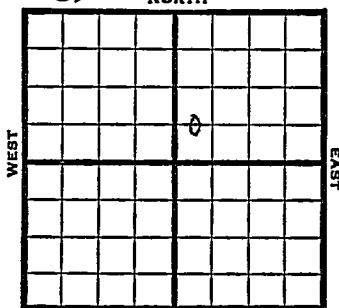

C W L SW NE

SOUTH

1949

Elev 1904'

REPORT

12/21

8" @ 320'

12/28

Drlg 570'

1950

1/11

TD 3740'

8"@ 320'

Br L 3346'

Lan 3359'

DST 3484-91

No shows.

Gong 3604'

Simp 3658'

Arb. 3710'

D&A

Aband.

ABANDONED

~~KANSAS~~

Wildcat

Map No. _____ Sec. 20 Twp. 21 R. 13W

Well No. 1 Pursel


Petroleum Inc. .

Company

Stag Drlg.

Contractor

C W L SW NE

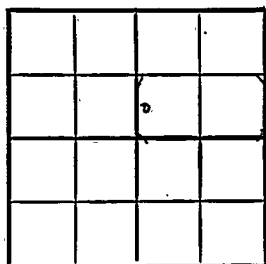FIRST REPORT
SECTION PLAT

_____ Ft. from N. Line

660 _____ Ft. from S. Line

_____ Ft. from E. Line

330 _____ Ft. from W. Line

Stafford County

Location _____

Rig up _____

Drilling and Remarks:

8" @ 320

RECORD

Cased _____ in., _____ ft.

Sand _____

Gas _____

Oil _____

Total Depth _____

PRODUCTION

1st 24 hrs. Nat. _____

1st 24 hrs. after shot _____

Gas _____ Cu. Ft.

Dry Hole _____

Abandoned _____

Date

DEC 21 1949 19

S. J. LEWIS

Scout

Map No. _____ Sec. 20 Twp. 21 R. 13WWell No. 1 Purcel

_____ Petroleum Inc. _____ Company

_____ Contractor


C W L SW NE

Flv. 1904
SECTION FLAT

_____ Ft. from N. Line

660 Ft. from S. Line

_____ Ft. from E. Line

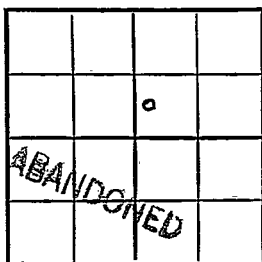330 Ft. from W. Line

Stafford County

Location _____

Rig up _____

Drilling and Remarks:

8" @ 320.Br. L 3346San 3359D.S.T. 3484-91no showscong-3604slip 3658ant 3710

Date

DYA.

RECORD

Cased _____ in., _____ ft.

Sand _____

Gas _____

Oil _____

Total Depth 3740

* PRODUCTION *

1st 24 hrs. Nat. _____

1st 24 hrs. after shot _____

Gas _____ Cu. Ft. _____

Dry Hole _____

Abandoned _____

JAN 11 1950

19

J. E. TYRA

Scout