


FORM 51 25M 3-49 PETROL

Section 20 Township 21 Range 13-W

Well No. #2 Koopman

Company Pet Inc.

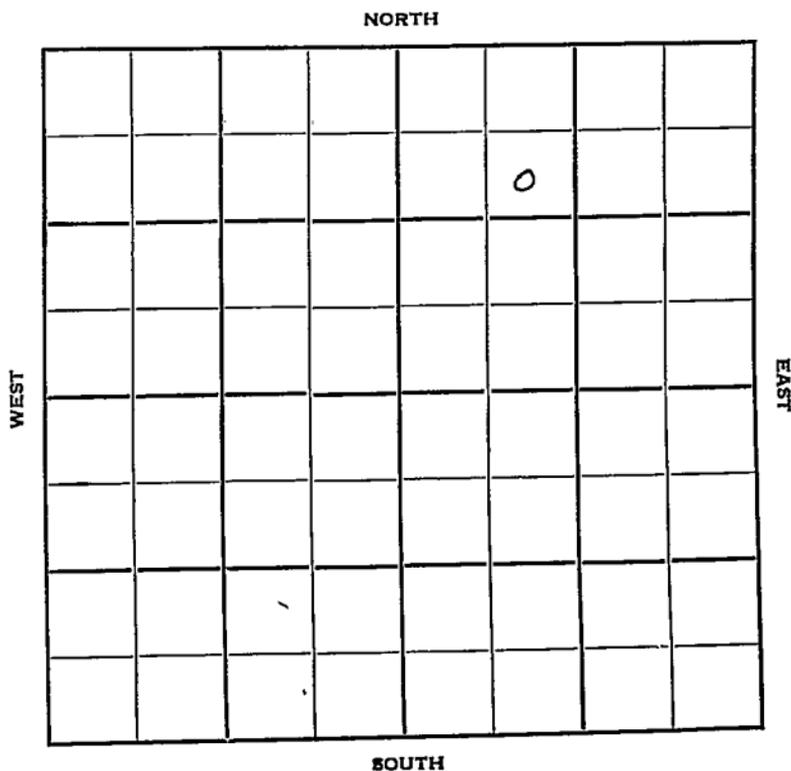

Stafford

Sec. 20 Twp. 21 R. 13W

Well No. #2 Koopman Farm _____
Pet. Inc. _____ Company


No Name

990' Ft. from N. Line

 Ft. from S. Line

 Ft. from E. Line

990' Ft. from W. Line

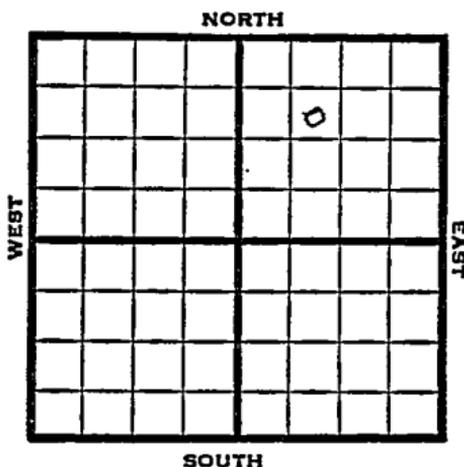

SE NW NE

1950

Elev 1904' REPORT

1/18

Spud 1-14-50

8" @ 206'

Drlg. 1655'

3/29

TD 3681'

8" @ 206'

5" @ 3676'

Lans 3350'

Viola 3592'

Arb. 3675'

398 BOPD

Comp

COMPLETED

Kansas

No name

Map No. _____ Sec. 20 Twp. 21 R. 13W

Well No. 2 Koopman

Pet. Inc. _____ Company

Contractor _____

SE NW NE

SECTION PLAT

990 Ft. from N. Line

_____ Ft. from S. Line

_____ Ft. from E. Line

990 Ft. from W. Line

		o	
FIRST REPORT			

Stafford County

Location _____

Rig up _____

Drilling and Remarks:

Spud 1-14-50

8" @ 206

drlg. 1655

RECORD

Cased _____ in., _____ ft.

Sand _____

Gas _____

Oil _____

Total Depth _____

PRODUCTION

1st 24 hrs. Nat. _____

1st 24 hrs. after shot _____

Gas _____ Cu. Ft.

Dry Hole _____

Abandoned _____

Date

JAN 18 1950

19

J. E. TYRA Scout

Kansas

Hazel, West

Map No. _____ Sec. 20 Twp. 21 R. 13W

Well No. 2 Koopman

Petroleum Inc. _____ Company

Contractor

SE NW NE

E1, 1904
SECTION PLAT

990 Ft. from N. Line

_____ Ft. from S. Line

_____ Ft. from E. Line

990 Ft. from W. Line

		o	
COMPLETE			

Stafford County

Location _____

Rig up _____

Drilling and Remarks:

8" @ 206
5" @ 3676
Lens 3350
Viola 3592
arb 3675
398 BOPD

RECORD

Cased _____ in., _____ ft.

Sand _____

Gas _____

Oil _____

Total Depth 3681

PRODUCTION

1st 24 hrs. Nat. _____

1st 24 hrs. after shot _____

Gas _____ Cu. Ft.

Dry Hole _____

Abandoned _____

Date

MAR 29 1950

J. E. TYRA

19

Scout