

Section 20 Township 21 Range 13W

Well No. #2 Schartz "B"

Company Cities Service

NORTH

WEST

EAST

	0						

SOUTH

Sec. 20 Twp. 21 R. 13W

Well No. #2 Schartz "B" Farm

Cities Service Company

Holm Drlg. - Contr. Contractor


_____ Ft. from N. Line

330' Ft. from S. Line

_____ Ft. from E. Line

990' Ft. from W. Line

SE SW SW

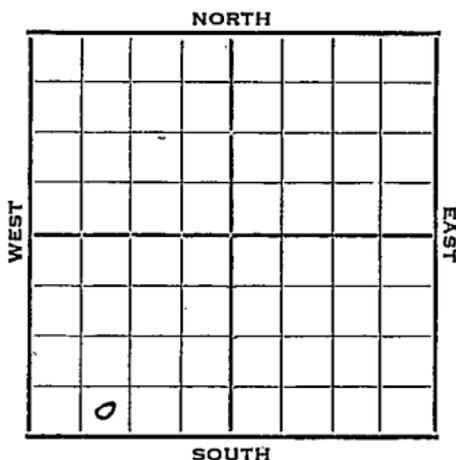

1952 Elev. 1908' REPORT

4/23 Location

4/30 "

5/7 8" @ 357

Drlg. 2330'

5/14 Br Li 3353' Lans. 3364'

DST 3381-3402, 1 hr. 37'm 150,000

gas DST 3402-20, 1 hr. 25'm

80# DST 3420-50, 1 hr. 120' HOCM

180 MCO 60' SMCO 1030#

Drlg. 3480'

5/21 DST 3482-3510' 1 hr. gas 15", 100'

H oily m 200' muddy oil 640' GCO

Arb. 3711' TD 3714 Schl.

5" @ 3712'

5/28 Cong 3599 V 3615 Simp Sh 3658

TD 3719 1130' oil 17 hrs.

6/11 P/ 2 Boph 500 A 8/109 B0 8 hrs.

6/18 NR

OVER

1952

6/25

Spud 5-2-52

Oil Well TD 3719

8" @ 357 Br Lime 3353

Lans. 3364

DST 3381-3402 opn 1 hr. Rec. 37' mud

150,000 gas DST 3402-20 opn 1 hr.

Rec. 25' mud DST 3420-50 opn 1 hr.

Rec. 120' hocm 180' mco 60' smco

DST 3482-3510 opn 1 hr. gas in

15 min. Rec. 100' hom 200' muddy

oil 640' gco Arb 3711 TD 3714

5" @ 3712 Cong. 3599 Viola 3615

Simp. 3658 TD 3719 FU 1130' oil

17 hr. P/2 boph 1500 A P/109 bo

8 hr. Comp. 294 bopd

COMPLETED

Scout Cards

Land Small Map

Land Wall Map

Tracings

France Map

Pierce Map

Misc.

APR

25 1952

Prig. Data

1951 2

Scout Cards
Land Small Map
Land Wall Map
Tracings
France Map
Pierce Map
Misc.