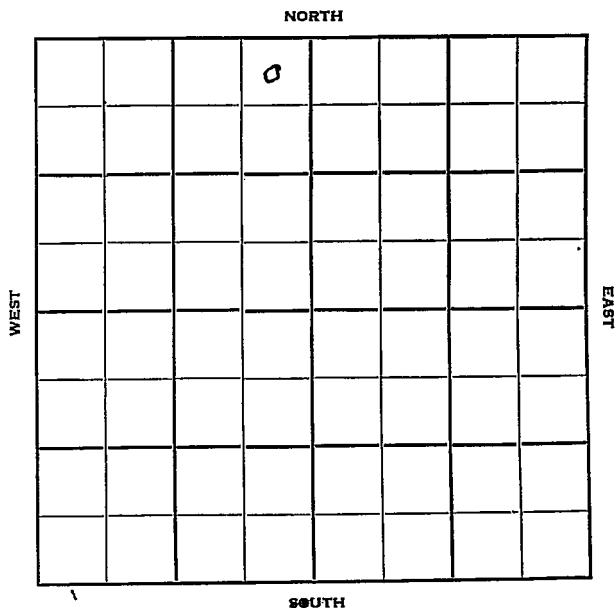


Section 20 Township 21 Range 13WWell No. #1 WalterCompany Harms & Knight

Sec. 20 Twp. 21 R. 13-W

Well No. #1 Walter Farm

Harms & Knight Company

Contractor

Hazel


330 Ft. from N. Line

Ft. from S. Line

330 Ft. from E. Line

Ft. from W. Line

NE NE NW

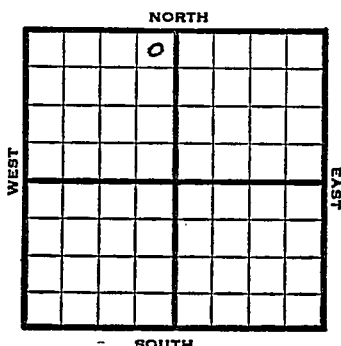

1950 Elev 1906' REPORT

12/13 Spud 12-8-50
8" @ 276'

1951
1/3 Spud 12-8-50
D&A TD 3721
8" @ 276' Anhy 786'
DST 3361-3402
opn $\frac{1}{2}$ hr Rec. 10' mud
Heeb. 3228' Br. Lime 3350
Lans. 3358'
DST 3481-91 opn $\frac{1}{2}$ hr
Rec. 5' mud Viola 3606
Simp. 3643' Arb. 3702
DST 3702-11
opn 50 mij Rec. 62' ho & gcm
5" @ 3702 DC 3703
10 goph DD 3721 HFW
D&A **ABANDONED**

County Stafford State KansasSec. 20 (Blk. Twp.) 21 (Sur. Rge.) 13W Map No.Operator Harms & KnightWell No. 1 Farm WalterElev. 1906 Location NE NE NW

		0			

FIRST REPORT

330 Ft. From N Line NW330 Ft. From E Line Quarter1st. Report DEC 13 1950

Completion


Remarks

Spudding Date 12-8-50

Drlg. Data

Hazel Pool8" @ 276

J. E. TYRA

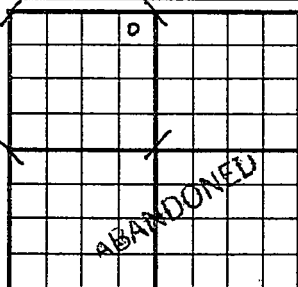County Stafford State KansasSec. 20 (Blk. 21 (Sur. 13W Map No.)
(Twp.) (Rge.)Operator Harms & KnightWell No. 1 Farm WalterElev. 1906 Location NE NE NW330 Ft. From N Line NW330 Ft. From E Line Quarter1st. Report Completion JAN 3 1951Remarks Hazel PoolSpudding Date 12-8-50Drlg. Data D & A TD 3721

8" C 276 Anhy 786 DST 3361-3402

open $\frac{1}{2}$ hr. Rec. 10' mud Heeb. 3228

Br. lime 3350 Lans. 3358 DST 3481-91

open $\frac{1}{2}$ hr. Rec. 5' mud Viola 3606

Simp. 3643 Arb. 3702 DST 3702-11

open 50 min. Rec. 62' ho & gcm 5" C 3702

DC 3703 10 goph DD 3721 HFV

D & A

J. E. TYRA