

Stafford

KANSAS

SECTION 20 TOWNSHIP 21 RANGE 14W

WELL NO. #1 Brown

COMPANY D.R.Lauck & SDX

NORTH

						0	

WEST

EAST

SOUTH

HOT FILE

Stafford

KANSAS

SEC.	TWP.	R.
20	21 S	14 W

WELL NO. # 1 Brown FARM

COMPANY Lauck & SDX (DEVELOPMENT-OBORG)

CONTRACTOR Lauck

NW Lincoln Field

330 Ft. from N. Line


Ft. from S. Line

990 Ft. from E. Line

Ft. from W. Line

of NE/4

NW NE NE

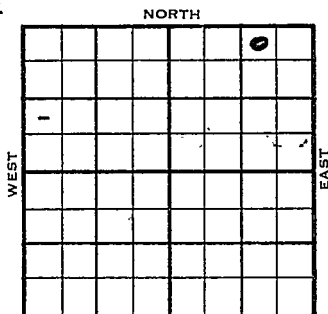

No Contract
(TWH6-EX4)

1956 ELEVATION 1937' GR 1939' REPORT 1941' KB

5/3 3820' Arbuckle Test
RUR. (FR Tkt)

5/2 Spudded 5-1-56
Drlg. surface hole. (DR#86)

5/3 TD 871'. WOC - 8-5/8" @ 870' w/400 sks

5/4 Drlg. 1900' (Card-Lauck Drlg. Co)

5/5 Drlg. 2210' "

5/6 Drlg. 2620' "

5/7 Drlg. 2635' (DR#89)

5/8 Drlg. 2985' (Card-Lauck Drlg.)

5/8 Drlg. 3220'

5/9 Drlg. 3405' "

5/10 Drlg. 3570' "

5/11 Drlg. 3677'

T. Heebner 3274 (-1333)

T. Brown Lime 3389 (-1448)

T. Lansing 3401 (-1460)

T. Viola 3661 (-1721)

DST #1, 3662-77', weak blow 5 min,
open 30 min, rec 5' mud. BHP 0#.
30 mins. (Card-Lauck Drlg.)

5/12 Drlg. 3745'

DST #2, 3718-3723, open 1 hr, SI 30"
rec 496' salt wtr w/scum oil. IFP 60#
FFP 500#. BHP 1012#. (Card-Lauck Drlg.)

OVER

1956
5/13

Drilg. 3790' TD. D & A
DST #3, 3750-3754' open 30 min,
40' muddy wtr. SI 30". IFP 0#
FFP 0#. BHP 1120#
TD 3790'. D & A (Card-Lauck Oil Co)

~~5/15~~

~~TD 3790'. Plugged & Abandoned (DR#95)~~

5/13

Simpson shale 3700(-1759)
Simpson sand 3717 (-1776)
Arbuckle 3790 (-1849)
RTD 3790(-1849)
Halliburton Tops: Heebner 3275',
Brown 3391', Lansing KC 3403', Base
KC 3622', Viola 3666', Simpson shale
3704', Simpson sand ~~3727~~ 3721',
Arbuckle 3754'. RTD 3794'.
DST #4, 3550-3574, after Elec. Log.
open 30", weak blow 8 min; rec.
8' mud; IFP 10# FFP 10#. BHP 80# 20".
D & A TD 3790' (See Driller's Log)
5/15 TD 3790'. Plugged & Abandoned (DR#95)

5/23

Received copies of Driller's Log.,
Geological Report, Plugging Record,
and Halliburton Radiation Guard Log.
Given to S.A. Shannon, Div. Geolog.
for Wichita Kansas District.

5-16

D&A
TD 3794'

ABANDONED

County Stafford Elev. _____
 Sec. 20 Twp. 21 Rge. 14W
 Company D.R. Lauck & Sunray Mid-Continent
 Farm Name Brown No. 1

TOPS	DEPTH	LOG	DATUM	Loc. in Sec.
Anb.				NW NE NE
Tr.				
H.				
Tr.				
Dg.				
BL.				
L.				
K.C.				Geol.
B.K.C.				Contr.
Ce.				<u>Track</u>
C.				
M.				Pool <u>LINCOLN</u>
M.				<u>WINGAT</u>
K.				
Mz.				
Mo.				
V.				
S.				
S.				
A.				
R.				
Pe.				
G.				
T.D.				

Date Comm.
R U R

GRIP & VAM

1000

County Stanford Elev. 1939 DF
 Sec. 20 Twp. 21 Rge. 11W
 Company D. R. Lauck & Sunray Mid-Continent
 Farm Name Brown No. 1

TIME	DEPTH	LOG	DATUM
R	3274		
Fr			
Dg			
BL	3389		
L	3401		
K.C.			
B.K.C.			
Ce.			
C.			
M.			
M.			
K.			
Mz.			
Me			
V.	3661		
S.	3703		
S. <u>sd</u>	3717		
A	3749		
R.			
PE			
G.			
TD	3794		

Loc. in Sec. NW NE NE

Geol. Lincoln

Contr. Wildcat

Pool Lincoln

ABANDONED

MAY 16 1956

Date Comm. Spd 5-1-56 85°R @ 870/400
10 3195 May 16 X HB 3274 BL 3389
LS 93401 Viola 3661 DST 3662-77
op 30" rec. 5' Md BHP 0 Sp 3703
Sp sd 3717 DST 3718-23 op 1hr
rec. 495' SW (sc. oil) FP 60-500
BHP 1012/20" F16 3749 DST 3750-54
op 30" rec. 40' WM BHP 1120/20"
RTD 3794 Ran Log
10' R