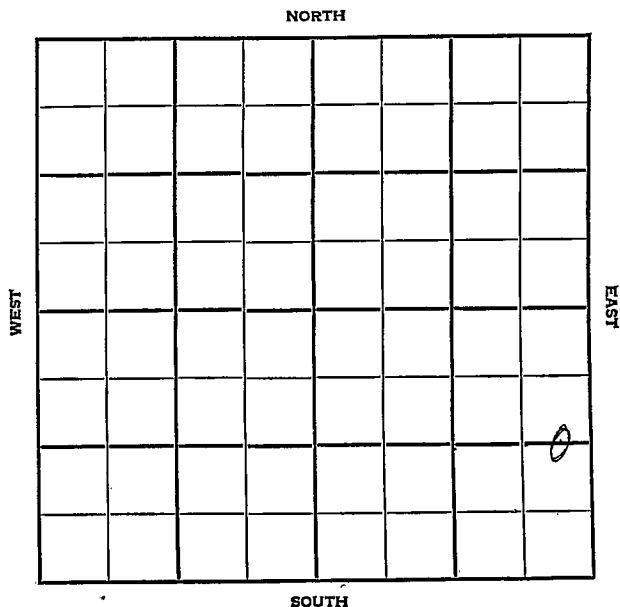


Section 20 Township 21 Range 14WWell No. #2 FullertonCompany D.R. Lauck & Sunray Mid-Continent Oil

HOT FILE

Stafford

KANSAS

SEC. 20 21 S 14 W

WELL NO.

2 Fullerton

FARM

COMPANY

D. R. Lauck & SDX (DEVELOPMENT-OBOC)

CONTRACTOR

Lauck


NW Lincoln Field.

FT. FROM N. LINE

1320 FT. FROM S. LINE

330 FT. FROM E. LINE

FT. FROM W. LINE

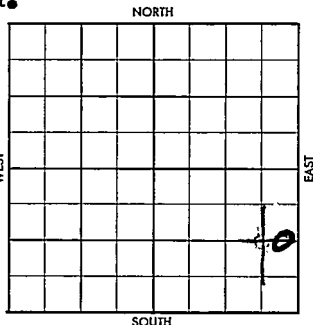

of Sec.

8-1/2-SE-1/4

C E/2 E/2 SE

	ELEVATION	REPORT
1957	1948' KB	
	3820' Simpson Test	
1/4	Spudded 1-3-57 8-5/8" @ 869' w/420 sax.	
	Drlg. 1090' (Card-D. R. Lauck)	
1/5	Drlg. 1670'	"
1/6	Drlg. 2125' (FR Tkt)	"
1/7	Drlg. 2560'	"
1/8	Drlg. 2695' (DR#6-1957)	
1/9	Drlg. lime @ 3210'	"
1/10	Drlg. 3215' 3404' Douglas Heebner 3304' DST 3562-76, op 30" rec 5' mud, BHP 0/20"	
1/11	Drlg. @ 3575' Lansing Douglas 3345', B. Lime 3421' Lansing 3430'	"
1/12	Drlg. @ 3707' B KC 3667' Cong 3695'	"
1/13	Drlg. 3755' Viola 3706' DST 3707'-25 Simp. Sh 3742' op 30", rec 10' mud. BHP 0/20". DST 3764-67, op 1 hr, rec	
1/15	Drlg. 3810' (DR#10-1957) ERROR	
1/16	TD 3810' NR (DR#11) 1385' SW. BHP 660/30"	
1/14	TD 3821'. D & A Simp. Sand 3764' Arb. 3796' (Card-D.R.Lauck Oil)	
1/17	TD 3821' D & A (DR#12-1957)	

ABANDONED

County Stafford Elev. _____
 Sec. 20 Twp. 21 Rge. 1 NW
 Company D. F. Lauck & Sunray M.d. Continent.
 Farm Name Fullerton No. 2

TOPS	DEPTH	LOG	DATUM	Loc. in Sec.
Anb.				C E $\frac{1}{2}$ E $\frac{1}{2}$ SE
Tr.				
H.				
Tr.				
Dg.				
Bl.				
L.				Geol. _____
K.C.				Contr. _____
B.K.C.				
Ce.				Lauck
C.				
M.				Pool
M.				NW Lincoln
K.				
Mz.				
Me.				
V.				
S.				
S.				
A.				
R.				
Pe.				
G.				
T.D.				

FIRST REPORT

JAN 9 '57

Date Comm. 1-3-57
8" @ 869/200 drlg. 2130

GE. AL. ALB

M M

County Stafford Elev. 5
 Sec. 20 Twp. 1 Rge. 1 NW
D.R. Lauck + unray M. i-Continent
Fullerton No. 2

TOPS	DEPTH	LOG	DATUM	Loc. in Sec.
Anh.				C F ¹ F ¹ SE
TP.				
H.	3304			
Tr.				
Dg.	3345			
BL.	3421			
L.	3430			
K.C.				Geol.
BKC.	3467			Conf.
Ce. <i>Marm</i>	3476			Lauck.
C.	3495			Pool
M.				NW Lincoln
M.				
K.				
Mz.				
Ma.				
V.	3706			
S.	3742			
S.				
A.	3796			
R.				
Pe.				
G.				
TD.	3821			

ABANDONED

JAN 28 '57

Date Comm. 7-3-57

8" @ 869/200 drl. 130 11 16" X H6

3304 Dg. 3345 BL. 3421 Lsg. 3430

DST 3562-76 op 30" rec 5' Mud BHP

0/20" BKC 3467 Cg. 3495 Vio. 3706

DST 3707-25 op 30" rec 10' Md BHP

0/20" sp. 3742 DST 3764-67 op 1 hr

rec 138.5' SW BHP 660/30" A16 3796

JAN 28 '57 X RTD 3821

D&A