


Section 20 Township 21 Range 14W

Well No. #1 Russell "B"

Company Petroleum, Inc.

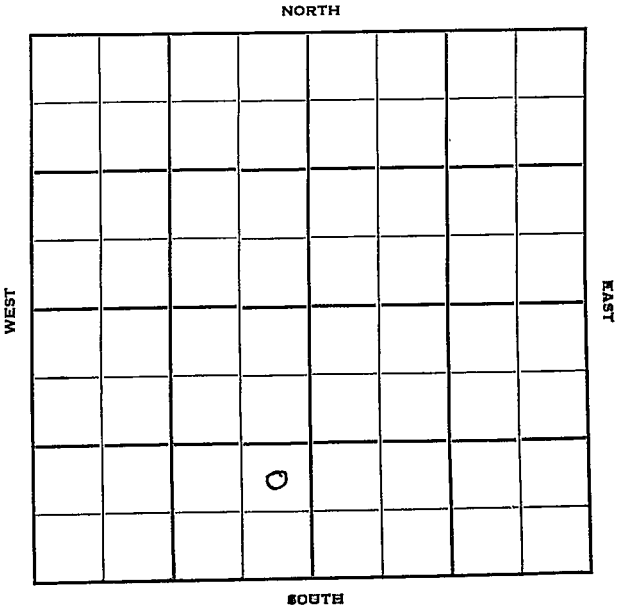

Stafford

KANSAS
14 W

Sec. 20 Twp. 21 R. 14 W ✓

Well No. # 1 Russell "B" Farm

Petroleum Inc. Company

Garvey Oil Contractor

Wildcat


 Ft. from N. Line

990 Ft. from S. Line

330 Ft. from E. Line

 Ft. from W. Line

NE SE SW

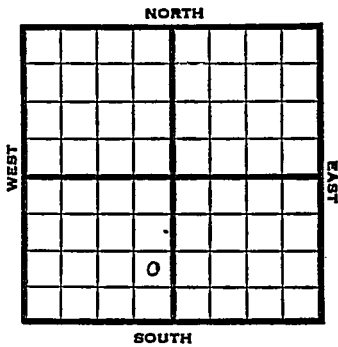

1951 Elev. 1944' REPORT

10/3 RUR
 10/17 Spud 10-2-51
 D&A TD 3821
 8" @ 255
 Anhy 870
 Br. line 3407
 Lans. 3418
 DST 3534-47 open 45 min.
 Rec. 25' mud
 Viola 3680
 Simp. 3727 ✓
 Arb. 3781
 TD 3821
 D&A

ABANDONED

