

(WH8-BH1) ✓


Stafford

KANSAS

SECTION 20 TOWNSHIP 21S RANGE 14W

WELL NO. #1 Russell

COMPANY D. R. Lauck & SDX

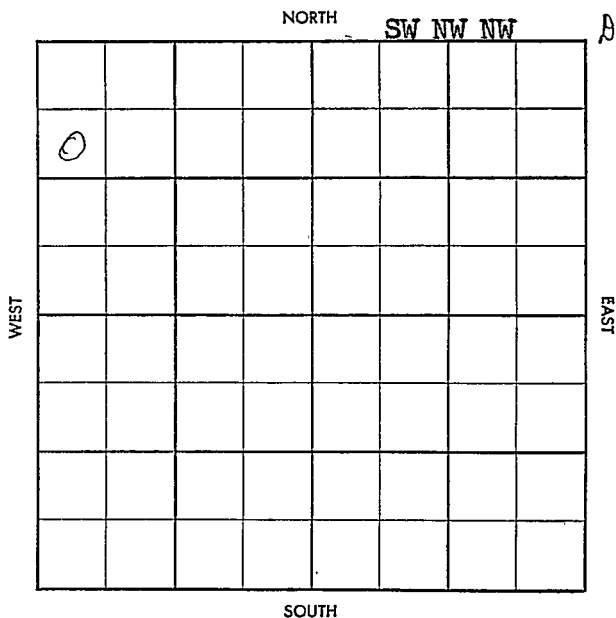


SEC. 20 TWP. 21 S R. 14 W

WELL NO. # 1 Russell FARM

COMPANY D. R. Lauck & SDX (EXPLORATORY-OBOG)

CONTRACTOR Co. tools
Bayer Pool

_____ FT. FROM N. LINE
_____ FT. FROM S. LINE
_____ FT. FROM E. LINE
_____ FT. FROM W. LINE

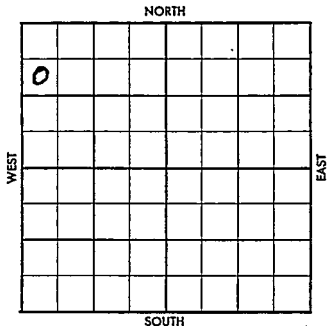

SW NW NW

FO Receivable-3/7/58-Phillips & SDX

	ELEVATION			
1958	1946'	RB	1943'	D ^{REPORT} (WH8-BH1) ✓
	3800'	Arb. Test		Arb. Test (FR Tkt)
4/2		WORT		
4/3		Spudded 4-2-58		
		Set 664' of 8-5/8" cement	csg. w/425 sks.	(Card-D.R. Lauck)
4/4		Drlg. 1693'		"
4/5		Drlg. 2185'		"
4/6		Drlg. 2675'		"
4/7		Drlg. 3050'		"
4/8		Drlg. 3260'	(DR#68)	"
4/9		Drlg. 3490'		
		Heebner 3274', Br. Lm 3381'		
		Lansing 3392'		"
4/10		Drlg. 3620'		"
4/11		Drlg. 3746'		"
4/17		TD 3780' Log TD 3779'		
		DST 3540-55, open 1 hr, weak blow, rec 90' muddy salt wtr. BMSIP 1210#		
		30" D & A (WH-Wkly Drlg. Rpt)		
4/17		TD 3780' P & A (DR#78)		
		Spud 4-1-58		
		8-5/8" @ 664 w/425 sks.		
		DST 3540-55' open 1 hr, weak blow, rec 90' muddy salt wtr. SIBHP 1210#/30		
		TD 3780' Log TD 3779' D & A		
		Log tops: H. 3273', Tr. 3290', BL 3380'		
		Lans. 3390', Vi. 3644', S. Sh 3693'		
		A. 3746' (See Scout Comp. Ticket)		

S-513-B

~~Log~~
~~Section~~
~~Section~~

County Stafford Elev. 1770 c. 11140
 Twp. 20 Twp. 21 Rge. 14W
 Loc. D. R. Lauck ~~SDX~~
 Name Russell No. 1

	DEPTH	LOG	DATUM
Anh.			
Tp.			
H.	3274	3273	
Tr.		3290	
Dg.			
B.L.	3381	3380	
L.	3392	3390	
K.C.			
B.K.C.	3622		
Ce.			
C.			
M.			
M.			
K.			
Mz.			
Mq.			
V.	3645	3644	
S. sh	3699	3693	
S. sd	3714		
A.	3746	3746	
R.			
Pf.			
G.			
T.D.	3780	3779	

Loc. in Sec. SW NW NW
(WH8-BH1)

Geol. _____
 Contr. _____
 Co. Tools _____
 Pool _____
Bayer

APR 16 '58
 0
 ABANDONED

Date Comm. 4-1-58
 WORT Arb Test. APR 9 1958 X 85 664/425

Ø 3220 APR 16 '58 DST 3540-55
 1 hr. wk. blo no. 90' new
 1210/30"

D+A

1958

M. M. L. W. C.

0
 Lse.
 No.
 Sec.
 T.
 R.