


Section 20 Township 21 Range 9-W

Well No. #1 Wellan

Company Herndon Drilling

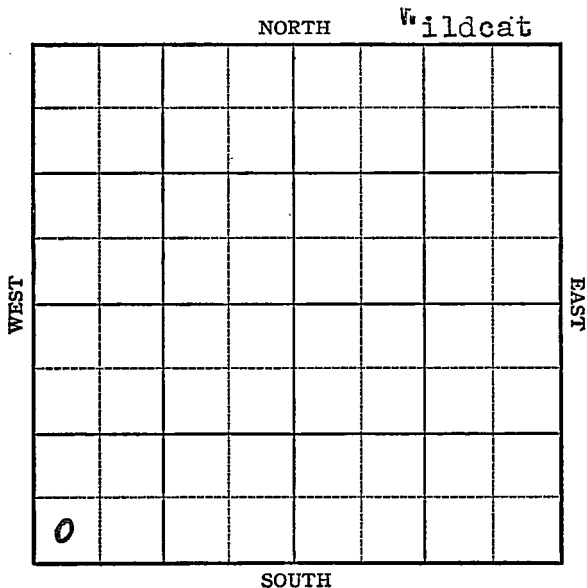



**KANSAS**

Rice

Map No. 49 Sec. 20 Twp. 21 R. 9WWell No. 1 WellanHerndon Drilling Company**FIRST REPORT** Contractor


SW/C

SECTION PLAT

\_\_\_\_\_ Ft. from N. Line

330 Ft. from S. Line

\_\_\_\_\_ Ft. from E. Line

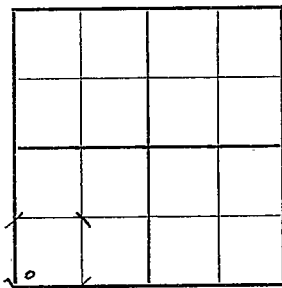330 Ft. from W. Line

WILDCAT

RECORD

Location \_\_\_\_\_

Cased \_\_\_\_\_ in., \_\_\_\_\_ ft.

Rig up \_\_\_\_\_

Sand \_\_\_\_\_

Drilling and Remarks:

Gas \_\_\_\_\_

8" - 258'

Oil \_\_\_\_\_

Total Depth \_\_\_\_\_

Waiting on  
cement to set

PRODUCTION g. ?

1st 24 hrs. Nat. \_\_\_\_\_

1st 24 hrs. after shot \_\_\_\_\_

Gas \_\_\_\_\_ Cu. Ft.

Dry Hole \_\_\_\_\_

Abandoned \_\_\_\_\_

Date

APR 15 1942 19 S. J. LEWIS Scout

Map No. 49 Sec. 20 Twp. 21 R. 9WWell No. 1 WellmanHerndon Drilling Company**ABANDONED** Contractor

SN/C

## SECTION PLAT

         Ft. from N. Line330 Ft. from S. Line         Ft. from E. Line330 Ft. from W. Line


WILD CAT

Location                                 Rig up                                 

Drilling and Remarks:

*Vid 3408*  
*Comp 3464*  
*Cr 3524*  
*No show.*

## RECORD

Cased          in.,          ft.Sand                                 Gas                                 Oil                                 Total Depth 3555

## PRODUCTION

1st 24 hrs. Nat.                                 1st 24 hrs. after shot                                 Gas                                  Cu. Ft.Dry Hole                                 Abandoned                                 

Date

APR 29 1942 19S. J. LEWIS Scout