


Section 20 Township 21 Range 10WWell No. #1 EngelCompany Flynn Oil Co.

NORTH

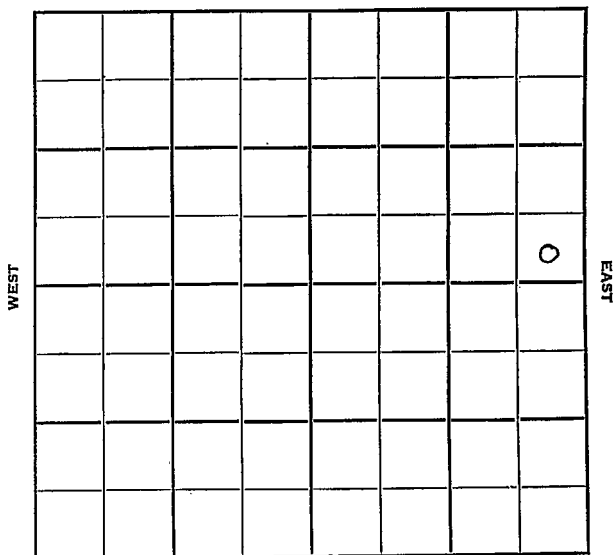

SOUTH

Rice

KANSAS

Sec. 20 Twp. 21 R. 10 W ✓

Well No. # 1 Engèl Farm

Flynn Oil Co. Company

Barbour Drlg. Contractor

Wildcat


 Ft. from N. Line

330 Ft. from S. Line

330 Ft. from E. Line

 Ft. from W. Line

SE SE NE
Phillips support

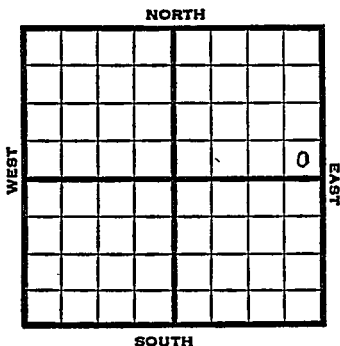

1951

Elev. 1728' REPORT

9/5

R U R

9/19

D&A TD 3485

Heeb. 2898 Br lime 3131

Lans. 3045 Viola 3356


DST 3352-61 opn ½ hr

Rec. 7' mud

Simp 3387 Arb. 3458-85 TD

D&A

ABANDONED

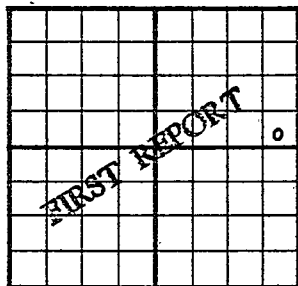County Rice State KansasSec. 20 (Blk.
Twp.) 21 (Sur.
Rge.) 10W Map No.Operator Flynn Oil Co.Well No. 1 Farm EngelElev. Location SE SE NE330 Ft. From S Line NE330 Ft. From E Line Quarter1st. Report SEP 5 1951


Completion

Remarks Phillips supportBarbour Drie. - Contr.

Spudding Date

Drlg. Data WildcatRUR

J. E. TYRA

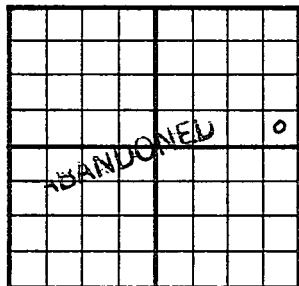County Rice State KansasSec. 20 (Blk.
Twp.) 21 (Sur.
Rge.) 10W Map No.Operator Flynn OilWell No. 1 Farm EngelElev. 1728 Location SE SE NE330 Ft. From S Line NE330 Ft. From E Line Quarter

1st. Report

Completion SEP 19 1951Remarks WildcatBarbour Drlg. - Contr.

Spudding Date

Drlg. Data D & A TD 3485Heeb. 2898 Br. lime 3131 Lans. 3045Viola 3356 DST 3352-61 open $\frac{1}{2}$ hr.Rec. 7' mud Simp. 3387 Arb. 3458-85 TDD & A

J. E. TYRA