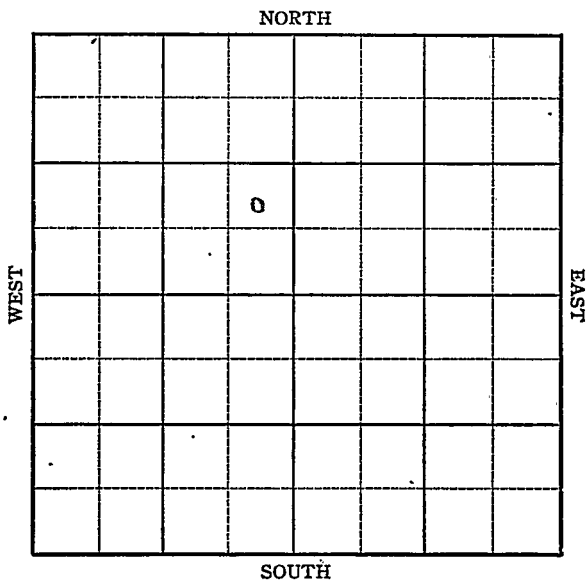


KANSAS

Stafford county

Section 20 Township 21 Range 11-WWell No. #1, Kasselmann "B"Company Champlin Refg.

KANSAS

Stafford ✓

Sec. 20 Twp. 21 R. 11TH

Well No. #1 Kasselmann "B" Farm

Champlin Ref. Company

Sand Hill


Ft. from N. Line

990 Ft. from S. Line

330 Ft. from E. Line

Ft. from W. Line

NORTH

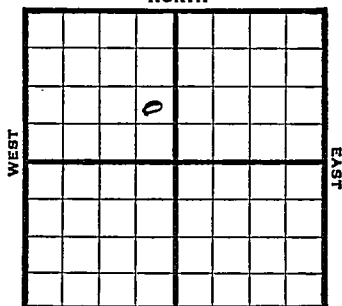

SOUTH

NE SE NW

1946 Elev. 1760' REPORT

11/6 RUR
11/12 8" @ 316'
Drlg 1925'
11/20 Drlg 3105'
11/27 Congl 3400'
Viola 3405'
TD 3466'

ABANDONED

Map No. 46 Sec. 20 Twp. 21 R. 11WWell No. 1 Kasselmann "B"


Champlin Ref. _____ Company _____

FIRST REPORT

Contractor _____

NE SE NW

SECTION PLAT

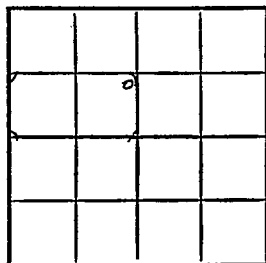

_____ Ft. from N. Line

990 Ft. from S. Line330 Ft. from E. Line

_____ Ft. from W. Line

Stafford County

Location _____

Rig up _____

Drilling and Remarks:

R U R

RECORD

Cased _____ in., _____ ft.

Sand _____

Gas _____

Oil _____

Total Depth _____

PRODUCTION

1st 24 hrs. Nat. _____

1st 24 hrs. after shot _____

Gas _____ Cu. Ft.

Dry Hole _____

Abandoned _____

Date

NOV 6 1946 19

S. J. LEWIS Scout

Map No. 46 Sec. 20 Twp. 21 R. 11W

Well No. 1 Kasselman "B"


Champlin Ref. _____ Company _____

ABANDONED

Contractor _____

NE SE NW

E11760
SECTION PLAT

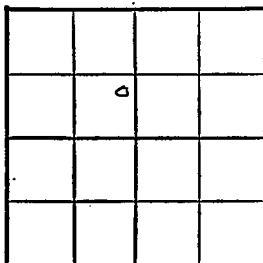

_____ Ft. from N. Line

990 Ft. from S. Line

330 Ft. from E. Line

_____ Ft. from W. Line

Stafford County

Location _____

Rig up _____

Drilling and Remarks:

Core 8400
Core 8405

RECORD

Cased _____ in., _____ ft.

Sand _____

Gas _____

Oil _____

Total Depth 2466

PRODUCTION

1st 24 hrs. Nat. _____

1st 24 hrs. after shot _____

Gas _____ Cu. Ft.

Dry Hole _____

Abandoned _____

Date

NOV 27 1946

19

S I LEWIS

Scout