


KANSAS

FORM 51 5M BRIX

Section 20 Township 21 Range 11W

Well No. "1 H. Smith "C"

Company Champlin Ref.

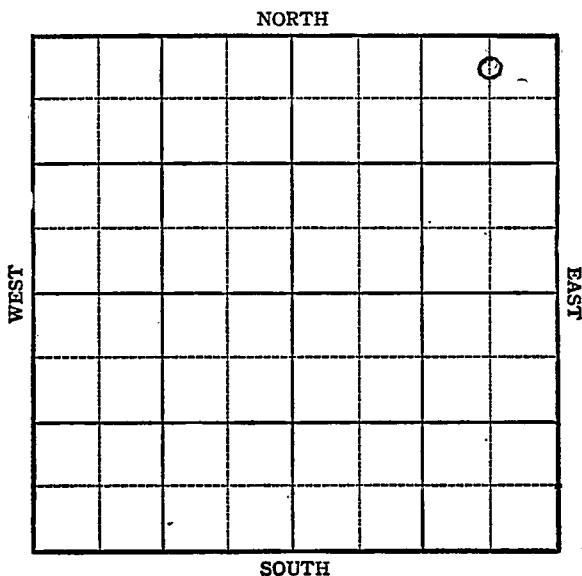

KANSAS

Sec. 20 Twp. 21 R. 11W
Well No. #1 H. Smith "C" Farm
Champlin Ref. Company


Wildcat

330 Ft. from N. Line

 Ft. from S. Line

660 Ft. from E. Line

 Ft. from W. Line

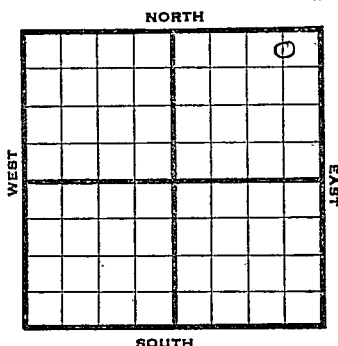

Stafford CNL NE NE

1944 *Elev. 1755* REPORT

11/29 RUR

12/6 8" @ 320'
Drlg. 2150

12/14 Drlg. 3240'

12/21 Cong 3363
Simp sd 3371-3378

TD 3378 SO
4" @ 3371' RUST

12/29 Swab 6 oil per hr.

1945

1/3 " " " "

1/10 " " " "

1/17 " " " "

1/26 " " " "

1/31 " " " "

2/7 " " " "

2/14 Simp. 3371
4" @ 3371
TD 3378'
Pump 121 Pot.
Grav. 46.0

COMPLETED

Pool Name WildcatMap No. 46 Sec. 20 Twp. 21 R. 11WWell No. 1 H. Smith "C"

Champlin Ref. _____ Company _____

FIRST REPORT

Contractor _____

CNL NE NE


SECTION PLAT

330 Ft. from N. Line

_____ Ft. from S. Line

660 Ft. from E. Line

_____ Ft. from W. Line

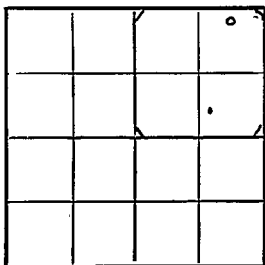

Stafford

Location _____

Rig up _____

Drilling and Remarks:

RUR

RECORD

Cased _____ in., _____ ft.

Sand _____

Gas _____

Oil _____

Total Depth _____

PRODUCTION

1st 24 hrs. Nat. _____

1st 24 hrs. after shot _____

Gas _____ Cu. Ft.

Dry Hole _____

Abandoned _____

Date

NOV 29 1944

19

S. J. LEWIS

Scout

Pool Name SniderMap No. K-46 Sec. 20 Twp. 21 R. 11WWell No. 1 H. Smith "C"Champlin Ref. CompanyCOMPLETED Contractor

C N L NE NE

SECTION PLAT

330 Ft. from N. Line Ft. from S. Line660 Ft. from E. Line Ft. from W. Line

			0

Stafford

Location Rig up

Drilling and Remarks:

*Shut 3371**4" C3371**Pump 121 P.D.**46° E*

RECORD

Cased in., ft.Sand Gas Oil Total Depth 3378

PRODUCTION

1st 24 hrs. Nat. 1st 24 hrs. after shot Gas Cu. Ft.Dry Hole Abandoned

Date

FEB 14 1945 19S. J. LEWIS Scout