


Pawnee

Section 20 Township 21 Range 16W

Well No. #1 Dick

Company Musgorve Petr.

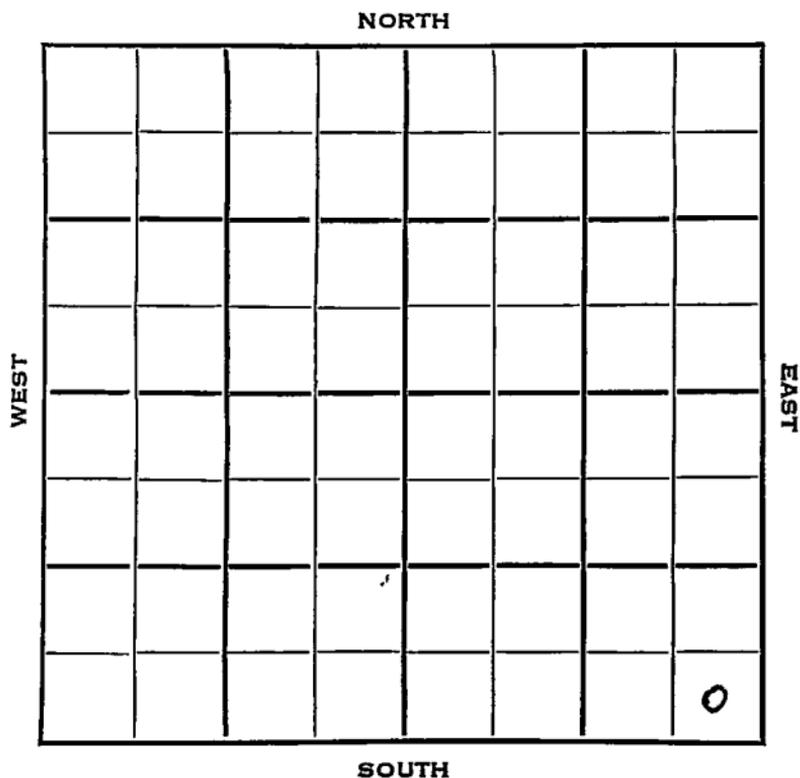

Sec. 20 Twp. 21 R. 16W

Well No. #1 Dick Farm

Musgrove Pet. Company

Musgrove Contractor
Wildcat.


Ft. from N. Line

330 Ft. from S. Line

330 Ft. from E. Line

Ft. from W. Line

SE SE SE
Magnolia F/O

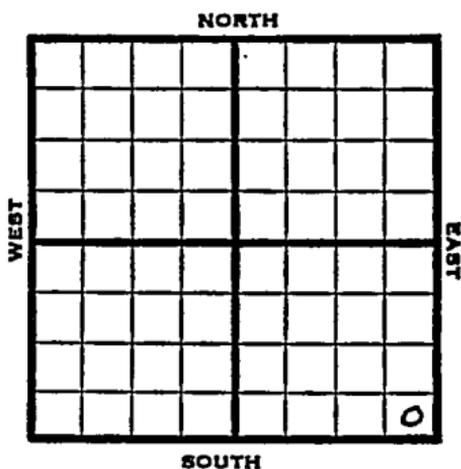

1953 Elev. 2008' REPORT

9/2 Spud 8-29-53
8" @ 1004'
Drlg 2405'

9/9 Spud 8-29-53
D & A TD 3940' 8" @ 1004
Heeb 3402 Tor 3419' Br li 3498'
Lans 3508 B KC 3762' Cong 3814'
Simp. 3846' Arb. 3882'
DST 3884-90' open 1 hr rec 5' mud
TD 3940'
D & A

ABANDONED

