


Section 20 - Township 21 Range 25 W

Well No. # 1 Jackson

Company Metropolitan et al

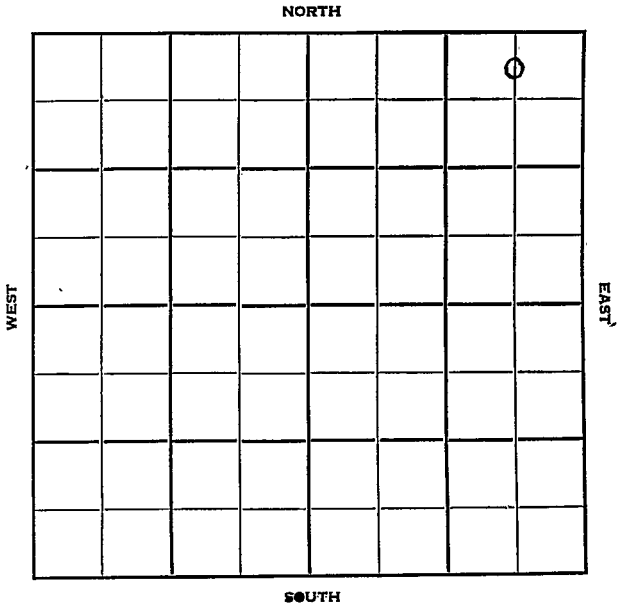

Sec. 20 Twp. 21 R. 25W **KANSAS** Hodgeman

Well No. #1 Jackson Farm

Metropolition et al Company

Coppiner - Contr. Contractor

Wildcat


330' Ft. from N. Line

 Ft. from S. Line

660' Ft. from E. Line

 Ft. from W. Line

N/2 NE NE

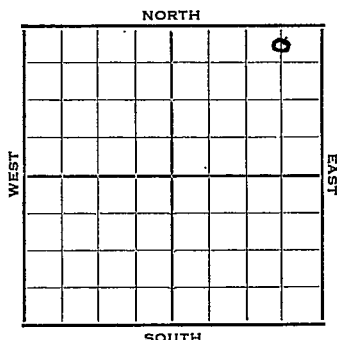


1952 Elev. 2324' REPORT

2/13 Spud 2-11-52
2/20 8" @ 388
Anhy 1525 Drlg. 3400'
3/5 Spud 2-11-52
D&A TD 4420
8" @ 388
Anhy 1525 Heeb. 3661
Lans. 3728 Top. 3430
Marm. 4062
DST 4318-30 open 1 hr. rec. 25' socm
DST 4330-61 open 1 hr. rec. 10' drlg.
mud TD 4420 Miss 4318
D&A

ABANDONED

J. G. McGEHEE

County Hodgeman State Kansas
 Sec. 20 (Blk. 21) (Sur. 25W) Map No.
 Operator Metropolitan etal.
 Well No. 1 Farm Jackson
 Elev. 2324 Location C N L NE NE

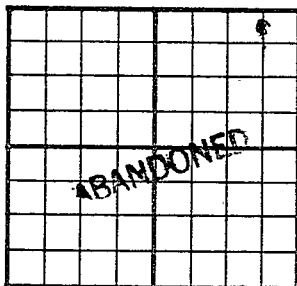

330 Ft. From N Line NE
665 Ft. From E Line Quarter
 1st. Report
 Completion MAR 5 1952
 Remarks Wildcat
Coppinger - Contr.
 Spudding Date 2-11-52

Drlg. Data D & A TD 4420
8" @ 388 Anhy 1525 Heeb. 3661
Lans. 3728 Top. 3430 Marm. 4062
DST 4318-30 open 1 hr. Rec. 25' socm
DST 4330-61 open 1 hr. Rec. 10' drlg.
mud TD 4420 Miss. 4318
D & A

J. G. McGEHEE