
FORM 51 25M 3-49 PETROL

Stafford KANSAS

Section 21 Township 21 Range 12W

Well No. #1 Grow

Company Pet. Inc.

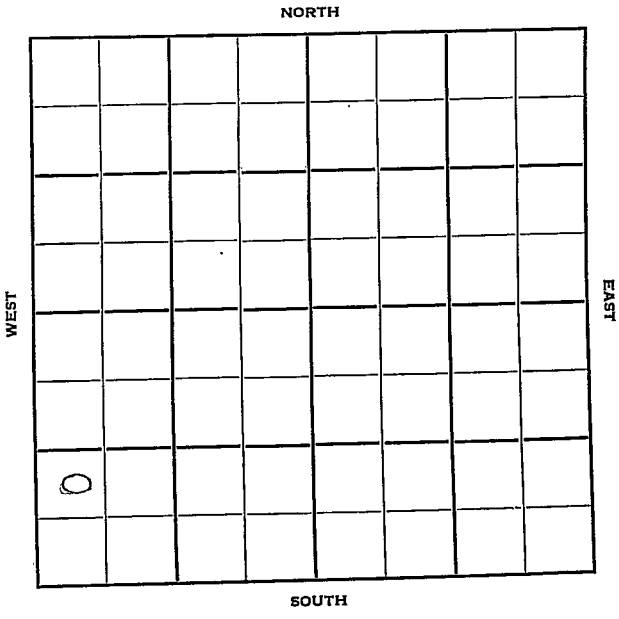

FORM 252-B
10M 9-49 PETROL

Stafford KANSAS ✓

Sec. 21 Twp. 21 R. 12W

Well No. #1- Grow Farm

Pet. Inc. Company

MCPC own SW/4 Sec. 19 Contractor

Mueller Pool


____ Ft. from N. Line

990' Ft. from S. Line

____ Ft. from E. Line

330' Ft. from W. Line

NW SW SW

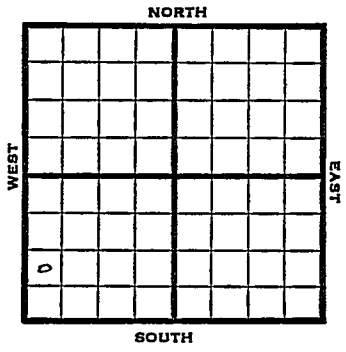

1950	REPORT
2/8	Spud 2-5-50 8" @ 217' WOC
2/22	8" @ 217' Heeb 3125' Viola 3514' Congl 3507' Simp sh 3541'-45' TD 3645' D&A

ABANDONED

Form 26 200 Bks. 11-49 Petrol Kansas

Mueller Pool

Map No. _____ Sec. 21 Twp. 21 R. 12W

Well No. 1 Grow

Pet. Inc. Company

M.C.P.C. owned SW/4 sec. 19 Contractor

NW SW SW

SECTION PLAT



_____ Ft. from N. Line

990 Ft. from S. Line

_____ Ft. from E. Line

330 Ft. from W. Line

Stafford County

Location _____

Rig up _____

Drilling and Remarks:

Spud 2-5-50

8" @ 217

WOC

RECORD

Cased _____ in., _____ ft.

Sand _____

Gas _____

Oil _____

Total Depth _____

PRODUCTION

1st 24 hrs. Nat. _____

1st 24 hrs. after shot _____

Gas _____ Cu. Ft.

Dry Hole _____

Abandoned _____

Date

FEB 8 1950 19 J. E. TYRA Scout

Form 26 200 Bks. 11-49 Petrol

Kansas

Mueller Pool

Map No. ____ Sec. 21 Twp. 21 R. 12W

Well No. 1 Grow


Petroleum Inc. Company

Contractor

NW SW SW

El. 1863

SECTION PLAT

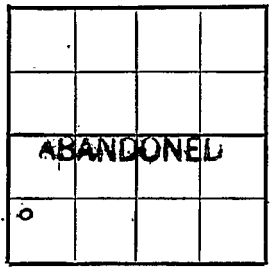

____ Ft. from N. Line

990 Ft. from S. Line

____ Ft. from E. Line

330 Ft. from W. Line

Stafford County

Location

Rig up

Drilling and Remarks:

8" @ 217
Heeb 3125
Viola 3514
Cong 3507
Simp Shale 3541
- 45 T.D.
D+A.

RECORD

Cased ____ in., ____ ft.

Sand

Gas

Oil

Total Depth 3645

PRODUCTION

1st 24 hrs. Nat.

1st 24 hrs. after shot

Gas ____ Cu. Ft.

Dry Hole

Abandoned

Date

FEB 22 1950 19

J. E. TYRA Scout