


Section 21 Township 21 Range 13W

Well No. #5 Hoffman

Company Petroleum Inc.

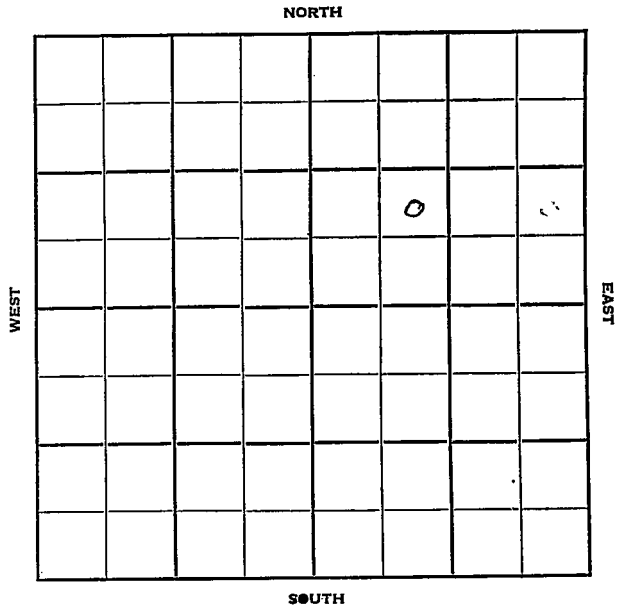

Stafford KANSAS

Sec. 21 Twp. 21 R. 13 W

Well No. # 5 Hoffman Farm

Petroleum Inc. Company

Jackson Contractor


_____ Ft. from N. Line

990 Ft. from S. Line

_____ Ft. from E. Line

990 Ft. from W. Line

NE SW NE

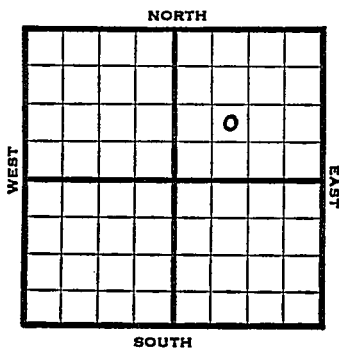

1952

Elev. 1892'

REPORT

1/16

Spud 1-12-52
8" @ 304'
Anhy 750'
Drlg. 2050'

2/6

TD 4142 5" @ 4141

2/13

No report

2/20

"

3/5

NR

3/12

Spud 1-12-52
D&A TD 4257
8" @ 304
Anhy 750 Heeb. 3212
Br Lime 3340 Lans. 3353
BKC 3573 Viola 3605
Simp 3655 Arb. 3705
TD 4142 5" @ 4141 DD 4257
300 A Comp. for SWD D&A

ABANDONED

