


Section 21 Township 21 Range 13W

Well No. #1 Hoffman

Company Ferrell Drlg.

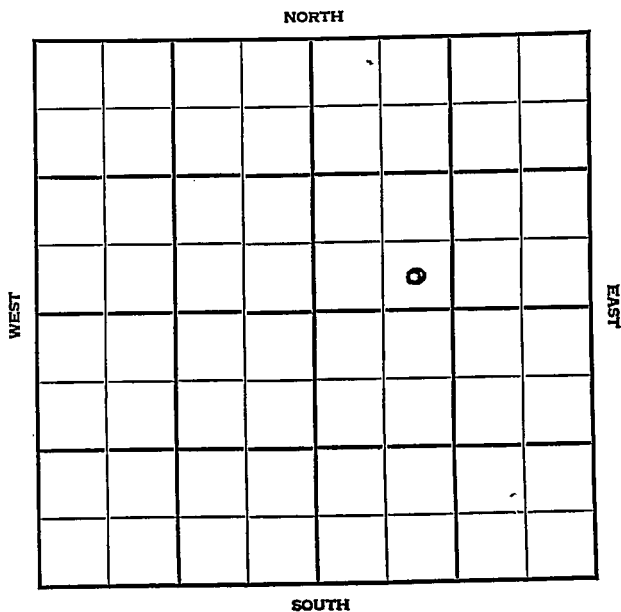

KANSAS

Stafford

Sec. 21 Twp. 21 R. 13W

Well No. #1 Hoffman Farm

Ferrell Drlg. Company

Hazel Pool

Ft. from N. Line

330'


Ft. from S. Line

Ft. from E. Line

990'

Ft. from W. Line

SE SW NE

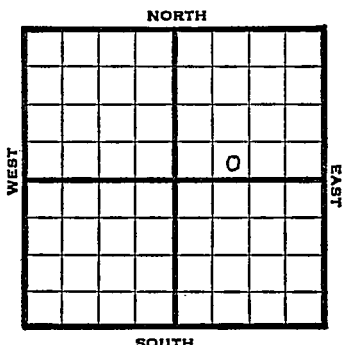

1948	Elev 1896'	REPORT
5/19	8" @ 221'	Drlg. 1301'
5/26	No report.	
6/1	"	
6/9	"	
6/16	TD 3704'	
	Arb. 3699'	
	5"@ 3699'	
	2100 acid	
	Aband.	
	ABANDONED	

Map No. _____ Sec. 21 Twp. 21 R. 13W

Well No. 1 Hoffman


Ferrell Drlg. Company

FIRST REPORT

Contractor

SE SW NE

SECTION PLAT

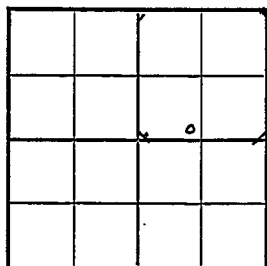

_____ Ft. from N. Line

330 Ft. from S. Line

_____ Ft. from E. Line

990 Ft. from W. Line

Stafford County

Location _____

Rig up _____

Drilling and Remarks:

8" @ 221'

drlg. 3101

RECORD

Cased _____ in., _____ ft.

Sand _____

Gas _____

Oil _____

Total Depth _____

PRODUCTION

1st 24 hrs. Nat. _____

1st 24 hrs. after shot _____

Gas _____ Cu. Ft.

Dry Hole _____

Abandoned _____

Date

MAY 19 1948 19 S. J. LEWIS Scout

Map No. 82 Sec. 21 Twp. 21 R. 13WWell No. 1 Hoffman

Ferrell Drlg.

Company

ABANDONED

Contractor

SE SW NE

E11896

SECTION PLAT

		o	

Ft. from N. Line

330

Ft. from S. Line

Ft. from E. Line

990

Ft. from W. Line

Stafford County

Location

Rig up

Drilling and Remarks:

OK 86995" @ 36992100 oil

RECORD

Cased _____ in., _____ ft.

Sand _____

Gas _____

Oil _____

Total Depth 8204

PRODUCTION

1st 24 hrs. Nat. _____

1st 24 hrs. after shot _____

Gas _____ Cu. Ft.

Dry Hole _____

Abandoned _____

Date

JUN 16 1948 19S. J. LEWIS

Scout