

Stafford


KANSAS

SECTION 21 TOWNSHIP 21 RANGE 13 W

WELL NO. #2 Sipes

COMPANY Chas. Hulme

NORTH

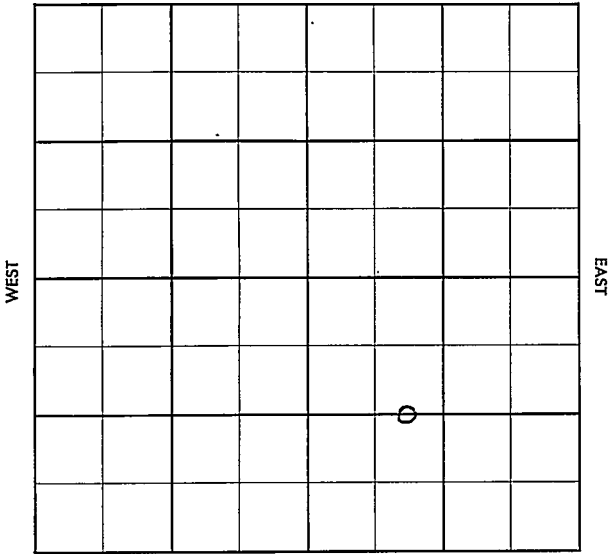

SOUTH

County Stafford Elev. 1890
 Sec. 21 Twp. 21 Rge. 13W
 Company Chas. Hulme
 Farm Name Sipes No. 2

TOPS	DEPTH	LOG	DATUM
Anh.			
Tp.			
H.			
Tr.			
Dg.			
Bl.			
L.			
K.C.			
B.K.C.			
Ce.			
C.			
M.			
M.			
K.			
Mz.			
Me.			
V.			
S.			
S.			
A.			
R.			
PE.			
G.			
T.D.			

Loc. in Sec. E $\frac{1}{2}$ W $\frac{1}{2}$ SE
 Geol. _____
 Contr. _____
Co. tools
 Pool _____
Hazel
 FIRST REPORT
 OCT 25 '55

Date Comm. 10-18-55
8" @ 263/125 d rlg. 3175

(Handwritten signature)

Co.
Lse.
No.
Sec.
T.
R.

County Starford Elev. 1890
 Sec. 21 Twp. 21 Rge. 13W
 Company Chas. Hulme
 Farm Name Sipes No. 2

TOPS	DEPTH	LOG	DATUM
Anh.			
Tp.			
H.	<u>.3215</u>		<u>1325</u>
Tr.			
Dg.			
Bl.	<u>.3345</u>		<u>1455</u>
L.	<u>.3359</u>		<u>1469</u>
K.C.			
B.K.C.			
Ce.			
C.			
M.			
M.			
K.			
Mz.			
Mo.			
V.	<u>.3607</u>		<u>1717</u>
S.	<u>.3714</u>		<u>1824</u>
S.			
A			
R.			
Pe.			
G.			
T.D.	<u>.3732</u>		

Loc. in Sec. E¹/₂ W¹/₂ SE

Geol. _____

Contr. _____

Co. tools _____

Pool _____

Hazel

ABANDONED

Date Comm. 10-18-55

NOV 2 1955

8th @ 263/125

D & A

Co.

Lse.

No.

Sec.

T.

R.