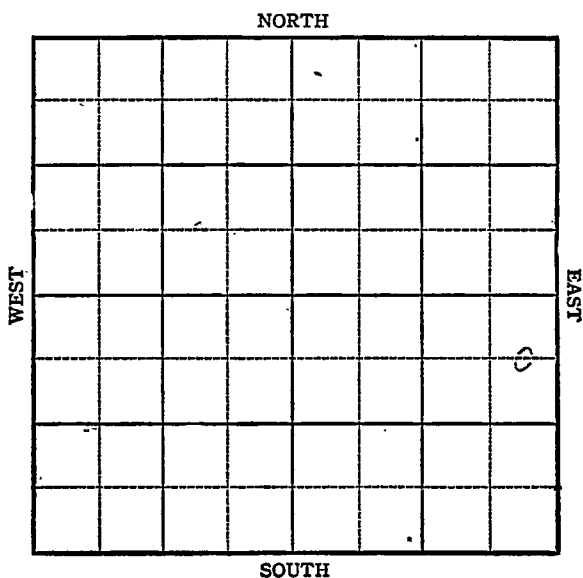


KANSAS

Stafford

Section 21 Township 21 Range 13WWell No. #2 Siepes "B"Company W F Faulkner

KANSAS

Stafford

Sec. 21 Twp. 21 R. 13W

Well No. #2 Siepes "B" Farm

W.P. Faulkner Company


Rothgarn

660' Ft. from N. Line

 Ft. from S. Line

330' Ft. from E. Line

 Ft. from W. Line

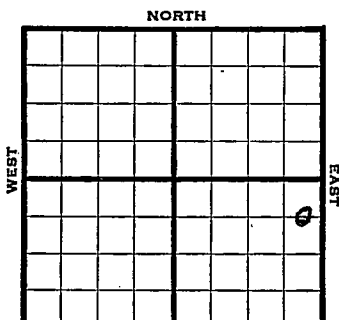

Elev. 1816

1944

R E P O R T

6/21 Drlg. 90'
6/28 8" @ 283
Anhy 750
Drlg 1885

7/19 Viola 3722
Simp. 3807
Arb. 3822
TD 3840

ABANDONED

KANSAS

Pool Name RothgarnMap No. 82 Sec. 21 Twp. 21 R. 13WWell No. 2 Siepes "B"W. P. Faulkner

Company

FIRST REPORT

Contractor

C E L N E S E SECTION PLAT

660 Ft. from N. Line Ft. from S. Line330 Ft. from E. Line Ft. from W. Line

Stafford

			o

Location Rig up

Drilling and Remarks:

Drlg. 90

RECORD

Cased in., ft.Sand Gas Oil Total Depth

PRODUCTION

1st 24 hrs. Nat. 1st 24 hrs. after shot Gas Cu. Ft.Dry Hole Abandoned

Date

JUN 21 1944 19S. J. LEWIS Scout

KANSAS

Pool Name RothgarnMap No. 8 Sec. 21 Twp. 21 R. 13WWell No. 2 Siepes "B"W. P. Faulkner

Company

ABANDONED

Contractor

C E L N E S E

SECTION PLAT

			o

660 Ft. from N. Line

Ft. from S. Line

330 Ft. from E. Line

Ft. from W. Line

Stafford County

Location

Rig up

Drilling and Remarks:

*Vista 3722**Smy 3707**Re 3822*

RECORD

Cased _____ in., _____ ft.

Sand _____

Gas _____

Oil _____

Total Depth 3840

PRODUCTION

1st 24 hrs. Nat. _____

1st 24 hrs. after shot _____

Gas _____ Cu. Ft.

Dry Hole _____

Abandoned _____

Date

JUL 19 1944S. J. LEWIS

Scout