

DX 78-1


Stafford

**KANSAS**

Section 21 Township 21S Range 11W

Well No. #2 Morrison

Company D. R. Lauck & SDX

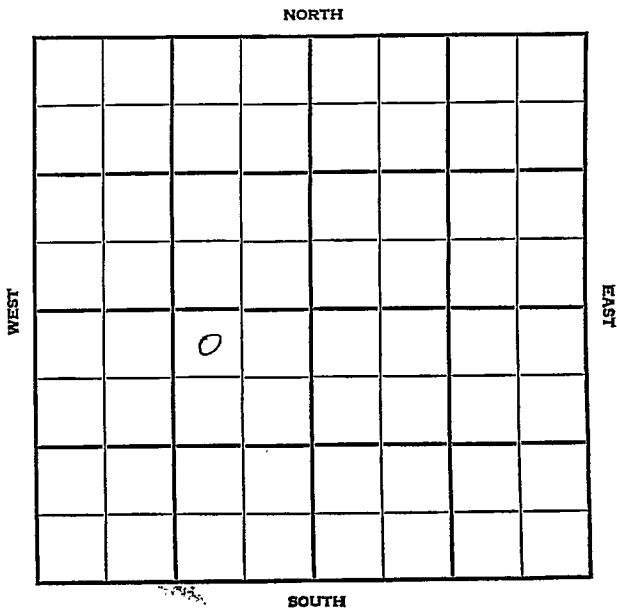

# HOT FILE Stafford KANSAS

SEC. <b>21</b>	TWP. <b>21 S</b>	R. <b>14 W</b>
-------------------	---------------------	-------------------

WELL NO. **# 2 Morrison** FARM

COMPANY **D. R. Lauck (DEVELOPMENT-OBOC)**

CONTRACTOR **& SDA Lauck**

**Nw Lincoln Field.**

330 FT. FROM N. LINE


FT. FROM S. LINE

990 FT. FROM E. LINE

FT. FROM W. LINE

of SW/4

NW NE SW

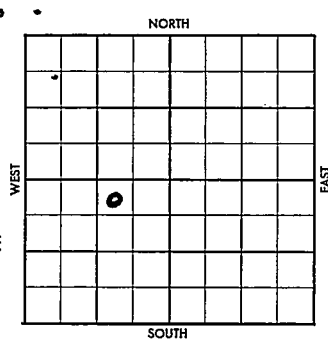

1956 ELEVATION **1938' GR; 1941' DR Report 1943' KB**

3850' Simpson Test

8/2 Spudded 7-31-56  
8-5/8" @ 850' w/425 sks. (FR Tkt)  
TD 850'. WOC. (DR#150)

8/2 Drlg. 1315' (Card-DR Lauck Oil)

8/3 Drlg. 2025' "

8/4 Drlg. 2440' "

8/5 Drlg. 2875' "

8/6 Drlg. 3155' "

8/7 Drlg. 3352' "

8/8 Drlg. 3555' "

8/9 Drlg. 3625' "

8/10 Drlg. 3685' "

8/10 Drlg. 3760' "

8/11 T. Heebner 3292 (-1349) T. Douglas  
3394 (-1451) T. Br. Lm 3411(-1468)  
T. Lansing 3420' (-1477)

DST #1, 3532-70, open 30", weak blow  
5", rec 15' mud. BHP 800# 20".

DST #2, 3701-10' open 30", weak blow  
5", rec 10' mud. BHP 0# 20".

DST #3, 3757-60', open 30", strong blow  
1 hour, rec 540' gas & 1200' fluid:  
700' gassy oil & 500' wtr. IFP 110#  
FFP 510#. BHP 790# 30".

OVER

1956

8/11

(Information continued)

Base K.C. 3655 (-1712)

T. Conglomerate 3688' (-1745)

T. Viola 3699' (-1756) T. Simpson Shale  
3731 (-1788) T. Simpson sd 3757(-1814)

T. Arbuckle 3786 (-1843)

RTD 3805'. 5" csg @ 3805'.

(Card-D.R. Lauck Oil)

~~8/13~~

~~TD 3760' XXXX DST 3757-60' rec 540'~~

~~gas 700' oil 110' FFP 510#.~~

8/16

Received copy of Drillers Log and  
copy of Electric Log - Given to S.A.  
Shannon, Div. Geolog, Wichita District

8/16

DRILLERS LOG: Comm. 7-31-56

Completed 8-10-56

8-5/8" @ 850 w/425 sks.

5 1/2" @ 3805 w/125 sax.

Tops: Sample: Heebner 3291, Doug 3333'

Br. Lm 3410', Lans. KC 3419', Base

KC 3653', Conglo 3685', Viola 3698',

Simp sh 3730', Simp. sd 3756',

Arb. 3785' RTD 3805'

Schl tops: Heeb 3292', Doug 3334',

Br Lm 3411', Lans. KC 3420', Base

KC 3655', Conglo 3688', Viola 3699'

Simp. sh 3731', Simp sd 3757',

Arb. 3786' RTD 3806'

DST #1 (W) 3532-3570, open 30", weak

blow 5 min, rec 15' mud. FFP 0#.

BHP 800# 20".

DST #2 (W) 3701-3710, op 30", weak

blow 5 min, rec 10' mud. FFP 0#.

BHP 0# 20"

DST #3 (W) 3757-3760' drlg.

3758-3761', Halliburton, open 1 hr,

strong blow 1 hr, rec 540' gas & 1200'

fluid, est. 700' clean gassy oil,

500' wtr. IFP 110# FFP 510#. BHP 790#

in 30 mins. (Driller's Log).

8/22

TD 3805'. Swabbing perfs 3757-3760'

8/23

TD 3805'. Swabbed @ 510 BO Day Rate.

Perfs 3757-3760'. Simpson Zone.

COMPLETE

(DR#165)

County Stafford Elev. \_\_\_\_\_  
 Sec. 21 Twp. 21S Rge. 14W  
 Company D. R. Lauck & SDX  
 FarmName Morrison No. 2

TOPS	DEPTH	LOG	DATUM	Loc. in Sec.
Anh.				NW NE SW
Tp.				
H.				
Tr.				
Dg.				
Bl.				
L.				Geol. _____
K.C.				Contr. _____
B.K.G.				<u>Lauck</u>
Ce.				
C.				
M.				
M.				Pool _____
K.				<u>Lincoln NW</u>
Mz.				
Me.				
V.				
S.				
S.				
A.				
R.				
PE.				
G.				
TD.				

FIRST REPORT

Date Comm. 7-31-56 AUG 8 '56  
8<sup>n</sup> 850 W/425; D. 3155

*Handwritten signature/initials*

MADE IN U.S.A.

MADE IN U.S.A.

County Stafford Elev. 1943 KB  
 Sec. 21 Twp. 21S Rge. 14W 1941D7  
 Company T. M. Lauck & SDX  
Morrison No. 2

	DEPTH	LOG	DATUM
Tr.			
H.	3291		
Tr.			
Dg.			
BL	3410		
L.	3419	3420	
K.C.			
B.K.C.		3655	
Ce.			
C.	3685	3688	
M.			
M.			
K.			
Mz.			
Mo.			
V.	3692	3699	
S. sh	3730	3731	
S. sd	37582	3757	12 4
A.		3786	
R.			
PE.			
G.			
TD.	3805	3805	

Loc. in Sec. \_\_\_\_\_  
 NW NE SW  
 Geol. \_\_\_\_\_  
 Contr. \_\_\_\_\_  
 Lauck  
 Pool  
 Lincoln NW

COMPLETE  
 SEP 19 '56

Date Comm. 7-31-56  
8# 850 w/425; D 3155 AUG 15 '56 Hb 32.91  
BL 3410 Lsg 3419 DST 3532-70  
op 30" rec. 15' Md. BHP 800 #  
Cg 3685 Viola 3692 DST 3701-10  
op 30" rec. 10' Mud All press 0  
sp sh 3730 sp sd. 37582 DST 3757-60  
op 1 hr. 540' gas rec. 700' gssy  
oil + 500' wtv FP 110-510 BHP  
790 RTD 3805 Log 5 1/2 @ 3805/125

Co.  
 Sec.  
 No.  
 Sec.  
 T.  
 R.

AUG 22 '56

MIGT CO? PF 20 shots  
in Arch tst wtr

PB 3769 18 / 3757-60 \$ 26

Bo + 17 BW in 2 hrs @ 45"

Ran T69 @ \$ 95 Bo + 1 BW in  
4 hrs

AUG 29 '56

R16 20 / 3786

-89. tst 1 BW (SSO) 17A \$ 45

BW-(SSO) no time T&amp;R.

SEP 5 '56

SEP 12 '56

SEP 19 '56

\*Phl. 74, 47 Bo  
+ 8% wtr 8 hrs cook. Phl.

223, 41 Bopd + 8% wtr

grain 35.4°

sp sd PF 3757-60

RTD 3805

PBTD 3769