

KANSAS

Section 21 Township 21 Range 11WWell No. #1 BledsoeCompany Ferrell Drlg.

NORTH

						0	

WEST

EAST

SOUTH

Stafford KANSAS
21 14 W

Sec. 21 Twp. 21 R. 14 W

Well No. # 1 Bledsoe Farm

Ferrell Drlg. Company


Wildcat Contractor

330 Ft. from N. Line

Ft. from S. Line

990 Ft. from E. Line

Ft. from W. Line

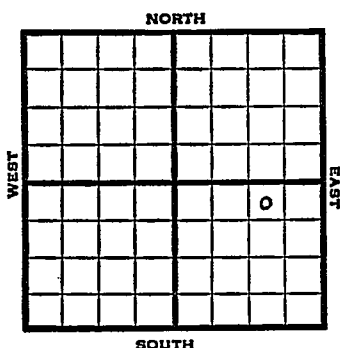


NW NE SE
Gulf farmout

1952 Elev. 1937' REPORT

1/2 8" @ 253'
Drlg. 825'

1/16 D & A TD 3810' 8" @253 Heeb 3293'
Lans. 3420'
DST 3559-92 open 45 min, rec 20' VSOCM
Viola 3688' Simp. 3735'
DST 3691-3738' open 45 min, rec 15'
mud.
Simp. 3756'
DST 3728-68 open 1/2 hr. rec 1920' wtr.
Arb. 3785'
TD 3810' D & A

ABANDONED

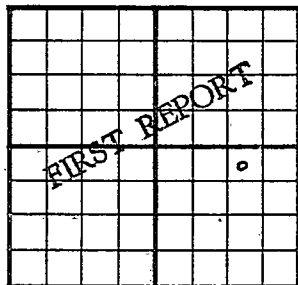County Stafford State KansasSec. 21 (Blk. Twp.) 21 (Sur. Rge.) 14W Map No.Operator Ferrell Drlg.Well No. 1 Farm BledsoeElev. Location NW NE SE330 Ft. From N Line SE990 Ft. From E Line Quarter1st. Report JAN 2 1952

Completion


Remarks Gulf farmout

Spudding Date

Drlg. Data Wildcat8" @ 253 drlg. 825

J. E. TYRA

County Stafford State Kansas
 Sec. 21 (Blk. 21) (Sur. 14W) (Twp.) (Rge.) Map No.
 Operator Ferrell Drlg.
 Well No. 1 Farm Bledsoe
 Elev. 1937 Location NW NE SE

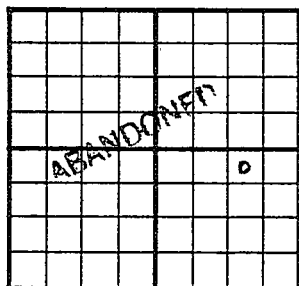

330 Ft. From N Line SE
990 Ft. From E Line Quarter
 1st. Report
 Completion JAN 16 1952
 Remarks Wildcat

Spudding Date

Drlg. Data D & A TD 3810

8" @ 253 Heeb. 3293 Lans. 3420

DST 3559-92 open 45 min. Rec. 20' vsocm

Viola 3688 Simp. 3735 DST 3691-3738

open 45 min. Rec. 15' mud Simp. 3756

DST 3728-68 open $\frac{1}{2}$ hr. Rec. 1920' water

Arb. 3785 TD 3810

D & A

J. E. TYRA