

Stafford

KANSAS

SECTION 21 TOWNSHIP 21 RANGE 14 W

WELL NO. #1 Morrison

COMPANY D. P. Lauck & Sunray Mid-Continent

NORTH

WEST

EAST

0							

SOUTH

LOT FILE

Stafford

KANSAS

SEC. A

TWP.

R.

21

21

1 1/4 W

WELL NO.

1 Morrison

FARM

COMPANY

D.R. Lauck & Sunray Mid-Continent

CONTRACTOR

Lauck


Ft. from N. Line

Ft. from S. Line

Ft. from E. Line

Ft. from W. Line

SW SW SW

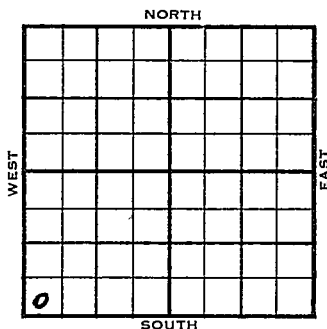

SDX - FO

1955

ELEVATION

1947

REPORT

11/9

Comm. 11-2-55
 8" @ 865/400
 Drlg. 2495'

11-17

Heeb. 3292
 Tor. 3314
 Doug. 3328
 Br. lime 3406
 Lans. 3416
 BKC 3652
 Marm. 3659
 Cong. 3685
 Viola 3688
 Simp. sh. 3726
 Simp. sd. 3748
 TD 3800

DST 3750-60 gas to surface in 30 min.
 op 1/2 hr. rec. 2570' free oil, 1160/20"
 Running guard log.

11-25

CO, 72/ 3748-60, FU 3000' oil 1 hr.,
 S/ 80 boph, setting unit,
 5 1/2" @ 3800/125

12-1

5 1/2" @ 3800/125

###

12-7

Comp. 344 bopd

DX-78

COMPLETED

3

County Stafford Elev. 1947
 Sec. 21 Twp. (2N) Rge. 14W
 Company D. R. Lauck & Sunray Mid-Continent
 Farm Name Morrison No. 1

TOPS	DEPTH	LOG	DATUM	Loc. in Sec.
Anh.				SW SW SW
Tr.				
Dg.				
BL.				
L.				Geol.
K.C.				Contr.
B.K.C.				<u>Lauck</u>
Ce.				Pool
C.				
M.				
M.				
K.				
Mz.				
Mo.				
V.				
S.				
S.				
A.				
R.				
Pe.				
G.				
T.D.				

FIRST REPORT
 NOV 9 '55

Date Comm. 11-2-55 Sunray MCOG farmout
8" @ 865/400 drlg. 2495

13

Scout Cards	<i>mm</i>
Land Small Map.....	<i>2</i>
Land Wall Map.....	
Tracings	
France Map	
Pierce Map.....	
Misc.....	

NOV 14 1955

County Stafford Elev. 1947
 Sec. 21 Twp. 21 Rge. 11W
 Company D. R. Lauck & Sunray Mid-Continent
 Farm Name Morrison No. 1

TOPS	DEPTH	LOG	DATUM	Loc. in Sec.
Anh.				SW SW SW
Ip.				
H.	3292	3292	1345	
Tr.	3314	3314	1367	
Dg.	3328		1381	
Bl.	3406	3406	1459	
L.	3416	3417	1470	Geol.
K.C.				
B.K.C.	3652	3642	1695	Contr
Ce. <u>main</u>	3659		1712	L
C.	3685	3686	1739	Lauck
M.				
M.				Pool
K.				NW Lincoln
Mz.				
Ma.				
V.	3688		1741	
S. <u>sh</u>	3726	3728	1781	COMPLETED
S. <u>sd</u>	3748	3748	1801	
A.		3783	1836	
R.				
Pe.				
G.				
TD.	3800			

Date Comm. 11-2-55 DEC 7 1955

8" @ 865/400 DST 3750-60 gas to surface
 in 30 min. open $\frac{1}{2}$ hr. rec. 2570' free
 oil 1160/20" TD 3800 CO 72/ 3748-
 60 FU 3000' oil 1 hr. S/ 80 boph
 5 $\frac{1}{2}$ " @ 3800/125 Comp. 344 boph

DEC 15 1955

R. G.