


SECTION 21 TOWNSHIP 21 RANGE 14 W

WELL NO. #1 Titus

COMPANY Lauck & Sunray Mid-Continean

NORTH

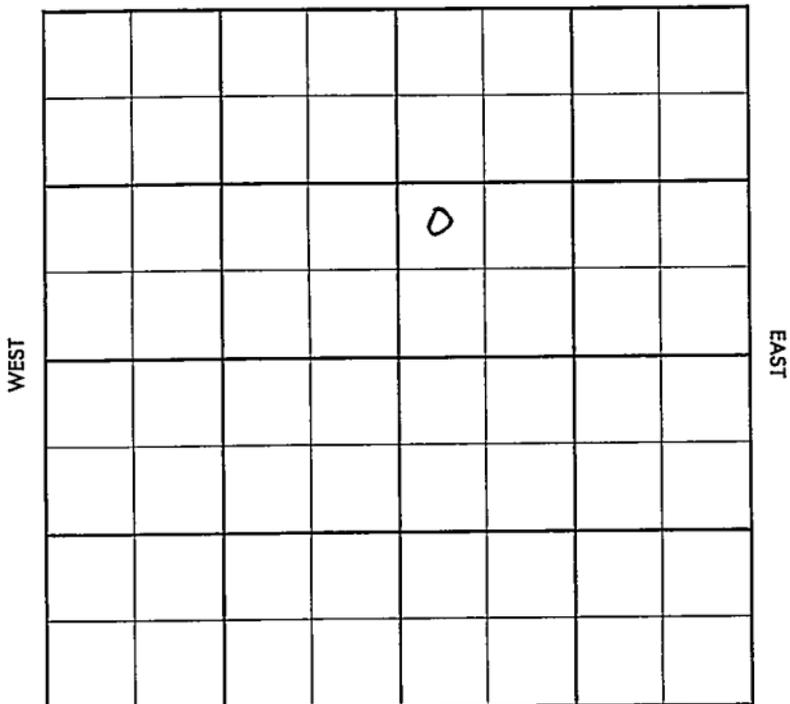

SOUTH

# HOT FILE      Stafford      KANSAS

SEC.      TWP.      R.

21      21 S      14 W

WELL NO.      # 1 Titus      FARM

COMPANY      Lauck & SDX (EXPLORATORY-OBOC)

CONTRACTOR      Lauck

Wildcat (NW Lincoln Field) NORTH


\_\_\_\_\_ Ft. from N. Line

990      Ft. from S. Line

\_\_\_\_\_ Ft. from E. Line

330      Ft. from W. Line

of NE/4  
NW SW NE

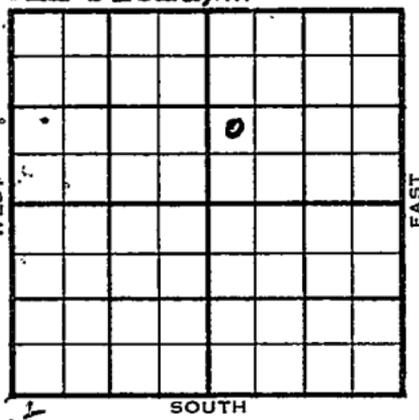

SDX - FO      NEVER Got it      No Contract

1956.      ELEVATION      REPORT      4-4-56

1942' KB      (WH5-EX22)

2/1      Projected Arbuckle Zone @ 3800'  
Location      (F.R.Tkt)

2/8      Spudded 2-7-56  
8-5/8" @ 862.      (Card-D.R. Lauck Oil)

2/10      Drlg. 1730'      (DR #30)

2/11      Drlg. 2125'      "

2/12      Drlg. 2455'      "

2/13      Drlg. 2850'      "

2/14      Drlg. 2850'      (DR#31)

2/14      Drlg. 3140'      (Card-DR Lauck Oil)

2/15      Drlg. 3140'      (DR#32)

2/15      Drlg. 3290'      (Card- Lauck Oil )

2/16      Drlg. 3460'

T. Heebner 3278 (-1336)

T. Br. Lime 3395 (-1453)

T. Lansing 3404' (-1462)      "

2/17      Drlg. 3590'      "

2/18      Drlg. 3722'      "

2/19      Drlg. 3770'

B. KC 3641 (-1699); T. Viola 3673(-173)

T. Simp. Sh 3715', T. Simp Sd 3735'

DST #1 (w) 3736-49' strong, 1 hr,  
rec 700' gas above 1040' gassy oil.  
IFP Off. FFP 330#. BHP 420# 20"  
T. Arb. 3761 (-1819) (Card-Lauck. Oil)

**OVER**

1956		
2/20	Drlg. 3590'	Tr.3301
2-21	TD 3778', WOC	Dg. 3318'
	5 $\frac{1}{2}$ " csg. Cmtd @ 3778'	
2-22	" "	"
2/23	TD 3778'	No report.
2/24	TD 3778'	"
2/27	TD 3778'	"
2/28	Received copies of Certified Driller's Log and Schl Laterolog Survey. - Given to S.A.Shannon-Div. Geolog.	
2/28	TD 3778'	No report.
2/29	TD 3778'	"
3/1	TD 3778'	"
3/2	TD 3778'	"
3/5	TD 3778'	"
3/6	TD 3778'	"
3/7	TD 3778'	"
3/8	TD 3778'	"
3/9	TD 3778'	"
3/12	TD 3788'	"
3-13	"	"
3-14	"	"
3-15	TD 3788'	"
3/16	TD 3788'	"
3-19	TD 3788'	No report
3/20	TD 3788'	"
3/21	TD 3788'	No report.
3/22	TD 3788'	"
3/23	"	"
3/26	TD 3788'	"
3/27	"	"
3/28	"	"
3/29	"	"
4/2	"	"
4/3	TD 3788'. Pumped 56 BO 24 hrs. Perfs 3721-3739', Arbuckle Zone COMPLETE (DR#65)	
4/4	No Contract-Do not advise contract sec.	
4-12	No report	
4-19	P/ 75 bopd, 25% wtr., Waiting on state test.	
4-25	Comp. 150 bopd, 12% wtr. TD # 3778'	
		<b>COMPLETED</b>

County Stafford Elev. \_\_\_\_\_  
 Sec. 21 Twp. 21 Rge. 11W  
 Company Lauck & Sunray Mid-Continent  
 FarmName Titus No. 1

Co.

TOPS	DEPTH	LOG	DATUM	Loc. in Sec.
Anh.				NW SW NE
Tp.				
H.				
Tr.				
Dg.				
Bl.				
L.				
K.C.				Geol. _____
B.K.C.				Contr. _____
Ce.				<u>Lauck</u>
C.				
M.				Pool _____
M.				<u>Wildcat</u>
K.				
Mz.				
Mo.				
V.				
S.				
S.				
A.				
R.				
PE.				
G.				
T.D.				

Lse.

FIRST REPORT  
 FEB 7 '36

No.

Date Comm. Sunray Mid-Continent FO  
 Location \_\_\_\_\_

Sec.

T.

R.

*(Handwritten scribble)*

SEP 3 1956

M. M.



MAY 4 1956

R. G.