

O.W.W.O.


DX 78-1 Pawnee

KANSAS

Section 21 Township 21 Range 15W

Well No. 1 Dix

Company Cities Service et al, Atlantic + LARIO

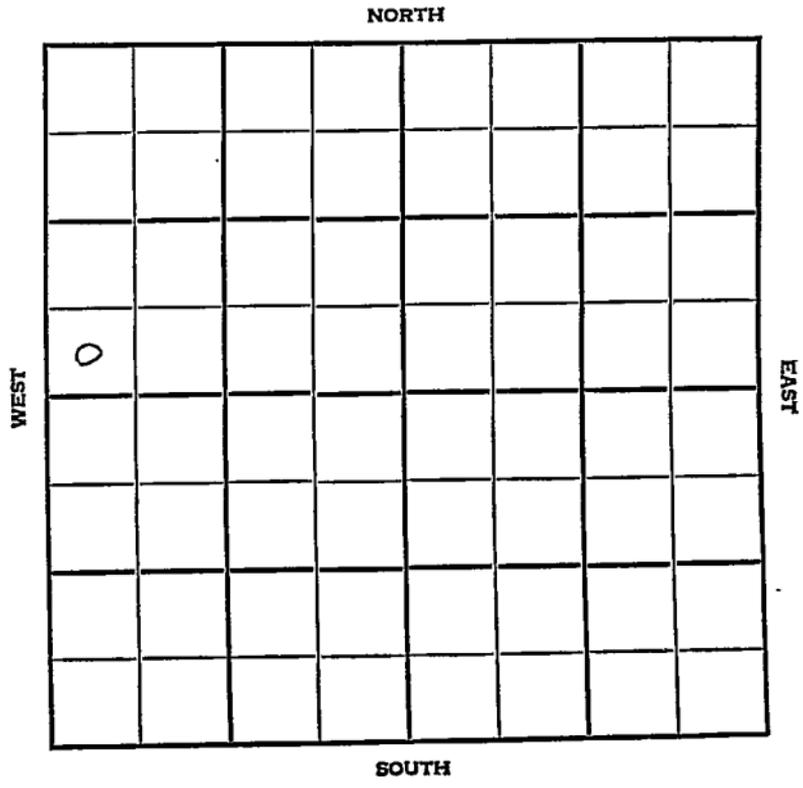

O.W.W.O.

Pawnee

KANSAS

SEC.	TWP.	R.
21	21	15 W


WELL NO. # 1 Dix FARM

COMPANY Cities Service, et al *Atlantic + Lario*

CONTRACTOR **Barbur**

~~Wildcat~~ *Sweeney*

_____ Ft. from N. Line
 330 _____ Ft. from S. Line
 _____ Ft. from E. Line
 330 _____ Ft. from W. Line

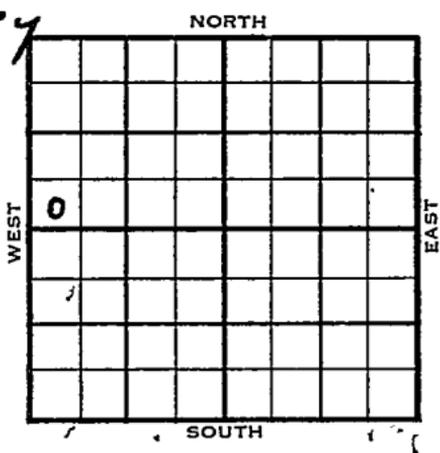

SW SW NW

1955	ELEVATION 1952'	REPORT
------	-----------------	--------

4/27 Spud 4-22-55
 8" @ 931 Anhy 922
 Drlg. 2040'

5/25 Top 2979'; Heeb 3317; Br Ls 3421;
 Lsg 3431; BKC 3662; Penn sd 3745;
 Simp sh 3796; Arb 3810; TD 3860
 8" 931
 DST 3474-3510 open 1 hr rec 90' mud
 & wtr., 1200#;
 DST 3746-55 open 1 hr, gas in 2 1/2 min,
 3,500,000 cfg, rec 30' gcm, 1200#;
 DST 3811-15 open 1 hr, rec 70' socm
 1122#;
 DST 3814-25 open 1 hr rec 55' M&w 200'
 smw 1205# 5 1/2 3860; steel line meas
 3860-56; CO 3840; 36/3741-47; swb 40
 bbl load, flo 3,762,000 cfgpd SIGW

COMPLETED

1956
 1/18 O.W.W.O.
 OTD 3860'. L. 3427', Sd 3741',
 Cong. ch. 3754', S. 3768', A. 3806'
 5" @ 3860 Perf 3741-47 3,762 MCFG
 42/3752-62. Comp. Shut in Gas well-
 2,570 MCFGPD. TD 3860'

FIRST REPORT

COMPLETED

O.W.W.O.

FORM 513 REV. SUNRA

OWWO

County Parnee Elev. 1952Sec. 21 Twp. 21 Rge. 15WCompany GSO, Atlantic & LarioFarm Name Dix No. 1

TOPS	DEPTH	LOG	DATUM	Loc. in Sec.
Anh.				SW SW NW
Tr.				
H.				
Tr.				
Dg.				
BL.				
L.	<u>3427</u>			Geol.
K.C.				Contr.
B.K.C.				
Ce.				Pool
C. <u>sd</u>	<u>3713</u>			<u>Sweeney</u>
M. <u>Cong. ch</u>	<u>3754</u>			
M.				
K.				
Mz.				
Mq.				
V.				
S.	<u>3768</u>			FIRST-REPORT JAN 18 '59 COMPLETE
S.	<u>3806</u>			
A.				
R.				
PE.				
G.				
T.D.	<u>3860</u>			

Date Comm.

5" @ 3860 perf/ 3741-47 3,762 mcfg42/ 3752-62 Comp. shut in gas well2,570 mcfgpd