


Section 21 Township 21 Range 11W

Well No. #10 Smith (B)

Company C.S.O.

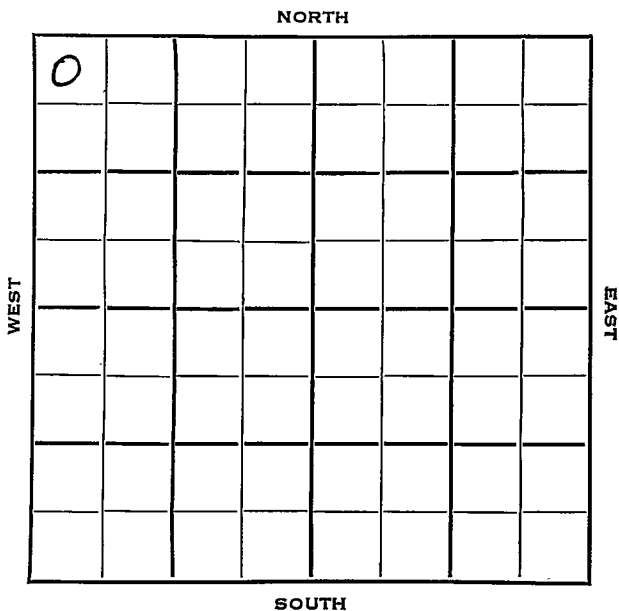

Sec. 21 Twp. 21 R. 11W

Well No. #10 Smith (b) Farm

C.S.O. Company

Barbour Contractor

Snider Pool


330 Ft. from N. Line

..... Ft. from S. Line

..... Ft. from E. Line

330 Ft. from W. Line

NW NW NW

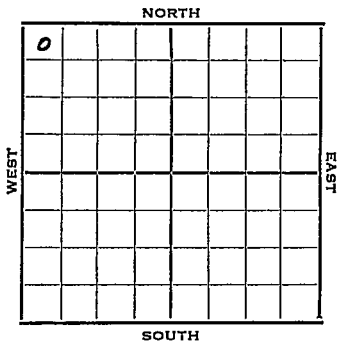

1953

Elev. 1752' REPORT

7/8

Spud 7-3-53
8" @ 352'
Drlg 1813'

7/22

Spud 7-3-53
D&A
TD 3440
8" @ 352
Doug 3022, Br line 3085, ¹/₄ ans 3103,
Simp 3372
DST 3369-83, opn 1 hr., rec. 190' socm
& sw 490#
Arb 3424
DST 3424-28, opn 3/4 hrs., rec. 10' mud
DS^I 3432-40, opn 1/2 hrs., rec. 20' mud,
980#
TD 3440
D&A

ABANDONED

County Stafford State Kansas

Sec. 21 (Blk. Twp.) 21 (Sur. Rge.) 11W Map No.

Operator C. S. O.

Well No. 10 Farm Smith (B)

Elev. _____ Location NW NW NW

0					

FIRST REPORT

330 Ft. From N Line NW

330 Ft. From W Line Quarter

Ist. Report JUL 8 1953

Completion _____

Remarks _____

Barbour - Contr.

Spudding Date 7-3-53

Drlg. Data Snider pool

8" @ 352 , Drlg. 1813

J. G. McGEHEE

County Stafford State Kansas

Sec. 21 (Blk. 21) (Sur. 11W) Map No.

Operator Cities Service

Well No. 10 Farm Smith "B"

Elev. 1752 Location NW NW NW

0				

330 Ft. From N Line NW

330 Ft. From W Line Quarter

1st. Report

Completion JUL ? 2 1953

Remarks Spider Pool

Barbour - Contr.

Spudding Date 7-3-53

Drlg. Data D & A TD 3440

8" @ 352 Doug. 3022 Br. lime 3085

Lans. 3103 Simp. 3372 DST 3369-83

open 1 hr. Rec. 190' soem & sw 490#

Arb. 3424 DST 3424-28 open 3/4 hr.

Rec. 10' mud DST 3432-40 open 1/2 hr.

Rec. 20' mud 980# TD 3440

D & A

J. G. MCGEHEE