

Stafford


FORM 51


KANSAS

Section 22 Township 21 Range 12W

Well No. 1 - Hammeke

Company Ed Adair & Lee Phillips

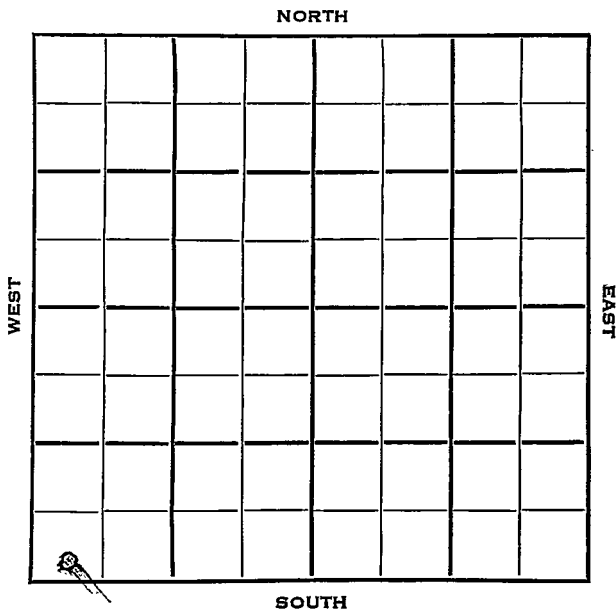

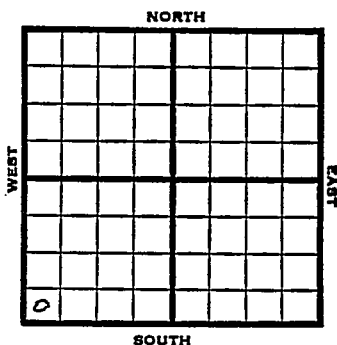Sec. 22 Twp. 21 R. 12WWell No. 1 Hammeke FarmEd Adair & Lee Phillips CompanyAdair Contractor       Ft. from N. Line330 Ft. from S. Line       Ft. from E. Line330 Ft. from W. LineSW SW <sup>NE</sup>SW

1952

Elev. 1845'

REPORT

|       |                                                                                             |
|-------|---------------------------------------------------------------------------------------------|
| 12/30 | RUR                                                                                         |
| 1/1   | RUR                                                                                         |
| 1/8   | 8" @ 326 Anhy 650 Ø1800                                                                     |
| 1/22  | Heeb 3108, Br Li 3246, KC<br>3261, V 3508, Simp 3528, Arb.<br>3586<br>RTD 3590<br>5" @ 3587 |
| 1/29  | DD 3600' B/1½ BOPH 2000 A                                                                   |
| 2/5   | Testing                                                                                     |
| 2/12  | NR                                                                                          |
| 2/19  | "                                                                                           |
| 2/26  | "                                                                                           |
| 3/12  | NR                                                                                          |
| 3/19  | NR                                                                                          |
| 3/26  | NR                                                                                          |
| 4/2   | "                                                                                           |
| 4/9   | "                                                                                           |
| 4/16  | "                                                                                           |
| 4/23  | "                                                                                           |
| 4/30  | "                                                                                           |

OVER

1953  
5/6

Spud 1-2-53

D&A

TD 3603

8" @ 326

Anhy 650, Heeb 3108, Br lime 3246, KC  
3261, Viola 3508, Simp 3528, Arb.  
3586

TD 3590

5" @ 3587

DD 3600, 500A

S/1 boph

DD 3603, B/1 $\frac{1}{2}$  boph, 2000A

S/1 $\frac{1}{2}$  boph, 1 $\frac{1}{2}$  bwph, 3 hrs.

FU 700' fluid, 15 hrs., 50% oil

D&A

**ABANDONED**

County **Stafford** State **Kansas**

Sec. 22 (Blk. 21 (Sur. 12W Map No.

Operator      Ed Adair & Lee Phillips

Well No. 1 Farm Hammke

| Elev. | Location | SW | SW | SW |
|-------|----------|----|----|----|
|-------|----------|----|----|----|

FIRST REPORT

330 Ft. From S Line SW

330 Ft. From W Line Quarter

1st. Report DEC 30 1952

### Completion

Remarks

Adair - Contr.

Spudding Date

Drlg. Data

RUR 4 5


J. G. McGEHEE

|                      |    |
|----------------------|----|
| Scout Cards .....    | SS |
| Land Small Map ..... |    |
| Land Wall Map .....  |    |
| Tracings .....       | 3  |
| French Map .....     |    |
| Pr no Map .....      |    |
| MISC .....           |    |

2 M. 2

1933

County Stafford State Kansas  
 Sec. 22 (Blk.) 21 (Sur.) 12W Map No.  
 Operator Ed Adair & Lee Phillips  
 Well No. 1 Farm Hammeke  
 Elev. 1845 Location SW SW SW

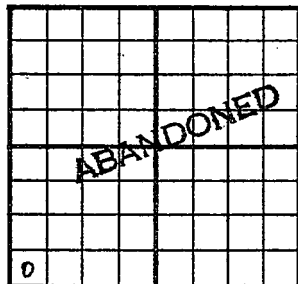

330 Ft. From S Line SW  
330 Ft. From W Line Quarter

1st. Report

Completion MAY 6 1953

Remarks

Adair - Contr.

Spudding Date 1-2-53

Drlg. Data D & A TD 3603

8" @ 326 Anhy 650 Heeb. 3108

Br. lime 3246 KC 3261 Viola 3508

Simp. 3528 Arb. 3586 TD 3590

5" @ 3587 DD 3600 500 A S/ 1 boph

DD 3603 B/ 1½ boph 2000 A

S/ 1½ boph 1½ bwph 3 hr.

FU 700' fluid 15 hr. 50% oil

D & A

MAY 12 1958

|                |    |
|----------------|----|
| Scout Cards    | 12 |
| Land Small Map |    |
| Land Wall Map  | 3  |
| Tracings       |    |
| France Map     |    |
| Pierce Map     |    |
| Misc.          |    |

Orig. Data