


Section 22 Township 21 Range 12W

Well No. #2 Rose

Company Virginia Drlg.

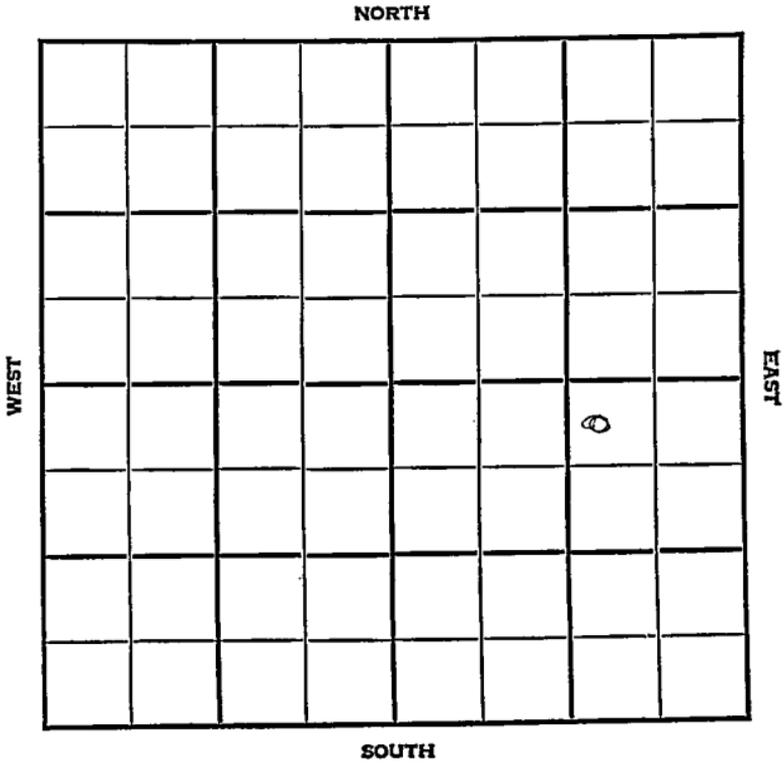

KANSAS

Stafford

Sec. 22 Twp. 21 R. 12-~~W~~

Well No. #2 Rose Farm

Virginia Drlg. Company

Sandigo


330' Ft. from N. Line

\_\_\_\_\_ Ft. from S. Line

990' Ft. from E. Line

\_\_\_\_\_ Ft. from W. Line

NW NE SE

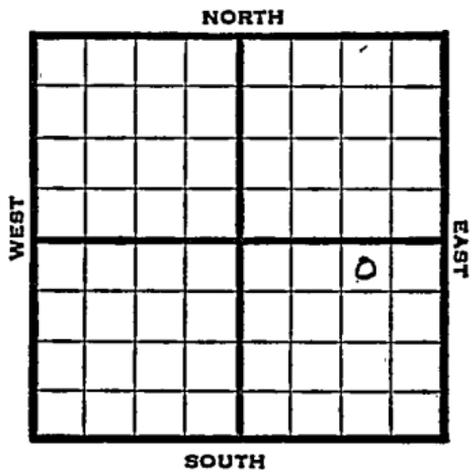

1947

Elev. = REPORT

11/25

8" @ 313'  
Lans. 3254'  
Drlg. 3526'

12/3

Viola 3630'  
Simp Sd 3658'  
Total Depth 3661'

**ABANDONED**

Map No. \_\_\_\_\_ Sec. 22 Twp. 21 R. 12W

Well No. 2 Rose

Virginia Drlg. Company

FIRST REPORT Contractor

NW NE SE

SECTION PLAT

330 Ft. from N. Line

\_\_\_\_\_ Ft. from S. Line

990 Ft. from E. Line

\_\_\_\_\_ Ft. from W. Line

			o

Stafford County

Location \_\_\_\_\_

Rig up \_\_\_\_\_

Drilling and Remarks:

8" @ 313

Lans. 3254

drlg. 3526 .

RECORD

Cased \_\_\_\_\_ in., \_\_\_\_\_ ft.

Sand \_\_\_\_\_

Gas \_\_\_\_\_

Oil \_\_\_\_\_

Total Depth \_\_\_\_\_

PRODUCTION

1st 24 hrs. Nat. \_\_\_\_\_

1st 24 hrs. after shot \_\_\_\_\_

Gas \_\_\_\_\_ Cu. Ft.

Dry Hole \_\_\_\_\_

Abandoned \_\_\_\_\_

Date

NOV 25 1947 19

S. J. LEWIS Scout

Map No. 246 Sec. 22 Twp. 21 R. 12W

Well No. 2 Rose

Virginia Drlg. \_\_\_\_\_ Company

**ABANDONED**

Contractor \_\_\_\_\_

NW NE SE

**SECTION PLAT**

330 Ft. from N. Line

\_\_\_\_\_ Ft. from S. Line

990 Ft. from E. Line

\_\_\_\_\_ Ft. from W. Line

			o

Stafford County

Location \_\_\_\_\_

Rig up \_\_\_\_\_

Drilling and Remarks:

*Vista 3630  
Simp. Blk 3658*

**RECORD**

Cased \_\_\_\_\_ in., \_\_\_\_\_ ft.

Sand \_\_\_\_\_

Gas \_\_\_\_\_

Oil \_\_\_\_\_

Total Depth 3481

**PRODUCTION**

1st 24 hrs. Nat. \_\_\_\_\_

1st 24 hrs. after shot \_\_\_\_\_

Gas \_\_\_\_\_ Cu. Ft.

Dry Hole \_\_\_\_\_

Abandoned \_\_\_\_\_

Date

**DEC 3 1947**

19

**S. J. LEWIS**

Scout