

22

21

12W

Sec. _____ Twp. _____ R. _____

#3 Rose

Well No. _____ Farm _____

Virginia Drlg.

Company _____

Virginia Drlg.

Contractor _____

Semi Wildcat

_____ Ft. from N. Line

990


_____ Ft. from S. Line

_____ Ft. from E. Line

330

_____ Ft. from W. Line

NW SW SE

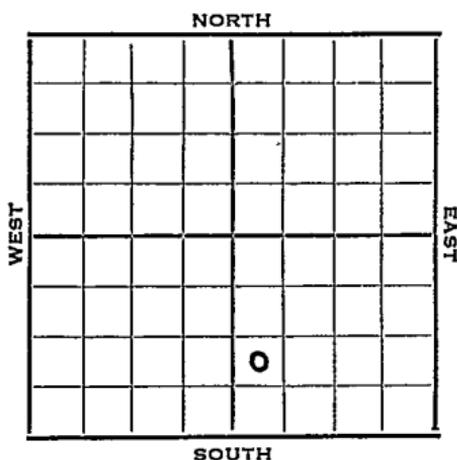

1952

Elev. 1844'

REPORT

12/10

RUR

12/11

RUR

12/18

8" @ 287 Anhy 650 Ø2800

12/25

" " " "

1/1

Br1 3244 Lans 3256 V 3500 Simp 3580
Arb 3582 RTD 3584 5" @ 3582

1/8 NR

1/22

DD 3595 TD 500A
S/50 BO 8 hrs., POP

1/29

NR

2/5

"

2/12

NR

2/19

"

2/26

"

3/11

Spud 12-9-52

Oil well TD 3595 8" @ 289

Anhy 650 Br lime 3244 Lans 3256

Viola 3500 Simp 3580 Arb. 3582

TD 3584 5" @ 3582 DD 3595

500 A S/50 BO 8 hr.

Comp. 152 BOPD

COMPLETED


County Stafford State Kansas

Sec. 22 (Blk. 21) (Sur. Rge.) 12W Map No.

Operator Virginia Drlg.

Well No. 3 Farm Rose

Elev. 1844 Location NW SW SE

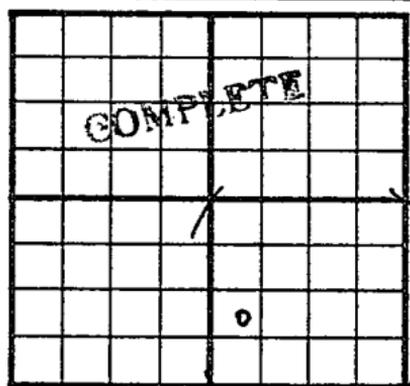

990 Ft. From S Line SE
 330 Ft. From W Line Quarter

Ist. Report

Completion MAR 11 1953

Remarks Semi Wildcat

Virginia Drlg. - Contr.

Spudding Date 12-9-52

Drlg. Data Oil well TD 3595

8" @ 289 Anhy 650 Br. lime 3244

Lans. 3256 Viola 3500 Simp. 3580

Arb. 3582 TD 3584 5" @ 3582

DD 3595 500 A S/ 50 bo 8 hr.

Comp. 152 bopd