

Sec. 22 Twp. R.

Well No. #4 Rose Farm

Virginia Drlg. Company

Virginia Drlg. Contractor

S. Saundra Pool


Ft. from N. Line

330 Ft. from S. Line

Ft. from E. Line

330 Ft. from W. Line

SW SW SE

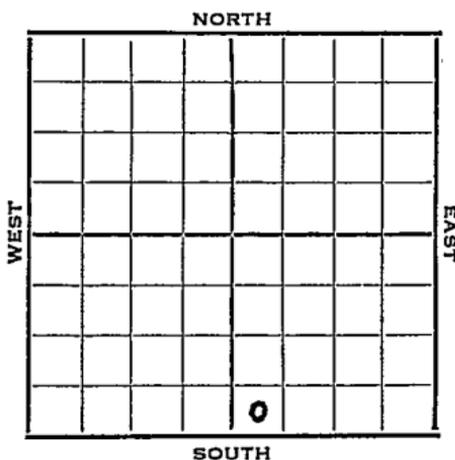

1953 Elev. 1843' REPORT

2/18 MIR

2/26 "

3/12 8" @ 280'

3/19 Heeb 3114, Br li 3252, KC 3263

Drlg. 3425'

3/25 Spud 3-8-53

D&A

TD 3691

8" @ 280

Heeb 3114, Br lime 3252, KC

3263, Cong 3512, Viola 3570,

Simp 3614, Ero Arb. 3655, Arb.

3683

TD 3691

D&A

ABANDONED

