


Section 22 Township 21 Range 12-W

Well No. #1, Taylor

Company Virginia Drlg. Company

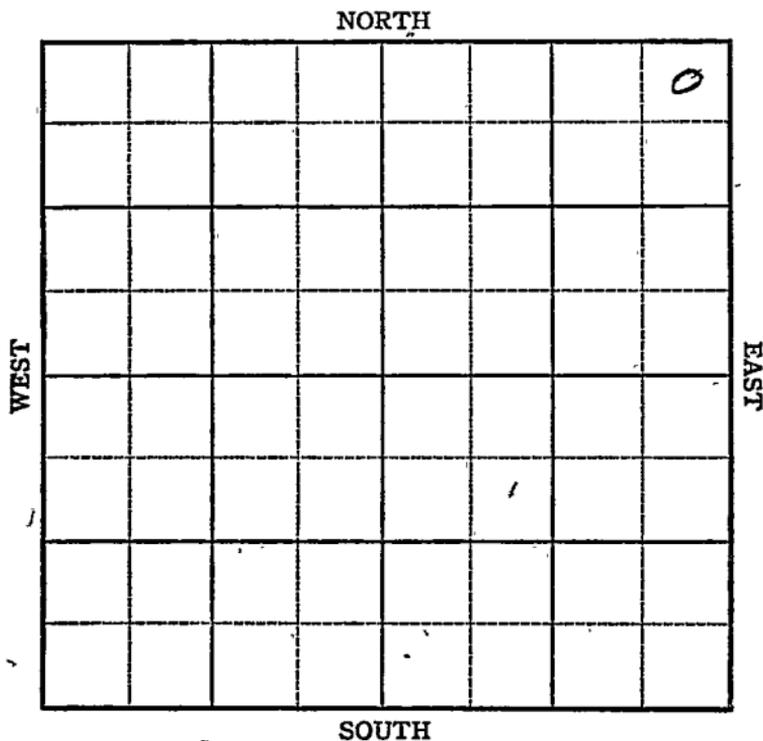

KANSAS

Stafford county ✓

Sec. 22 Twp. 21 R. 12-W

Well No. #11 Taylor Farm
Virginia Drilling Company Company
Mueller Pool


330' Ft. from N. Line

Ft. from S. Line

330' Ft. from E. Line

Ft. from W. Line

NE/C

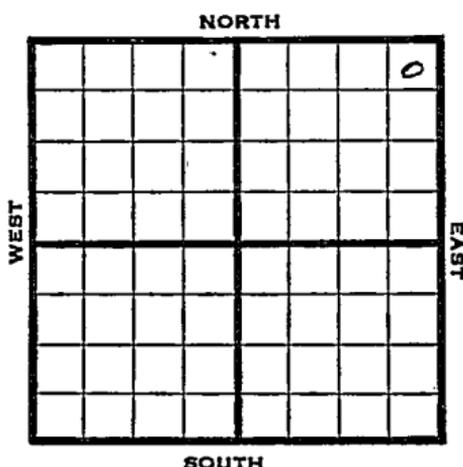

1946

Elev. 1838

REPORT

12/11	R U R
12/17	"
1947	
1/4	8" @ 300' Drlg. 800'
1/8	Anhy 638' Drlg 2640'
1/15	Laws 3250 Cong 3490 Simp 3506 Arb 3550 TD 3552' 5" @ 3551 RUST
1/21	" "
1/29	TD 3557 Arb 3549 5" @ 3551 4000 Acid Pump 474 Pot 39.3 Gravity

COMPLETED

Map No. A6 Sec. 22 Twp. 2E R. 12W

Well No. 1 Taylor

Virginia Drlg. Company

COMPLETE

Contractor

NE/C

E1, 1888

SECTION PLAT

330 Ft. from N. Line

 Ft. from S. Line

330 Ft. from E. Line

 Ft. from W. Line

			0

Stafford County

Location

Rig up

Drilling and Remarks:

223579
5" @ 3531
400 acid
Pump 474
09-3/8

RECORD

Cased in, ft.

Sand

Gas

Oil

Total Depth 3531

PRODUCTION

1st 24 hrs. Nat.

1st 24 hrs. after shot

Gas Cu. Ft.

Dry Hole

Abandoned

Date

JAN 29 1947 19

S. J. LEWIS Scout