


Section 22 Township 21 Range 12W

Well No. #1 Taylor

Company Honaker Drlg.

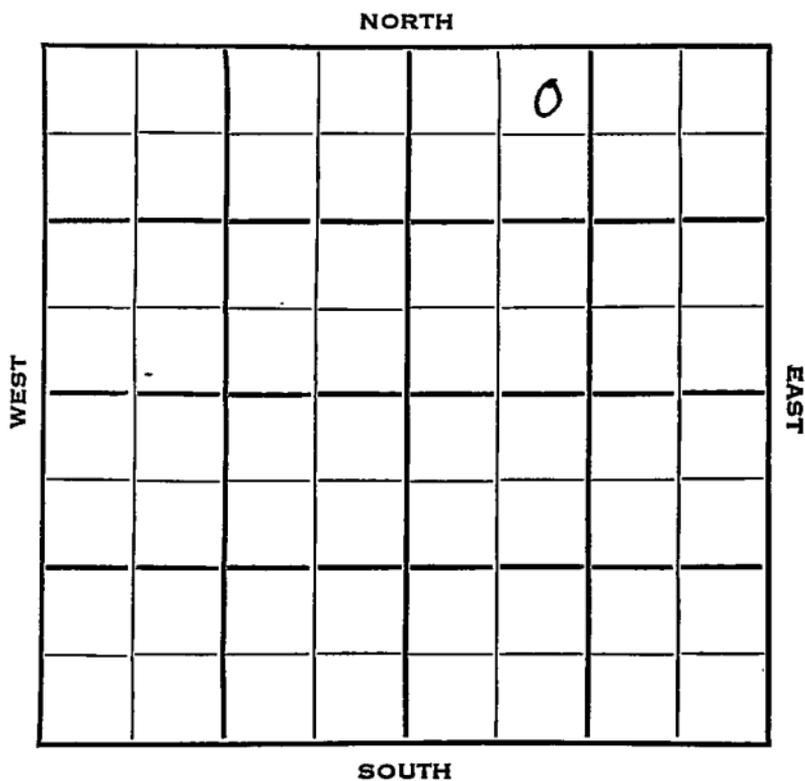

22

21

12W

Sec. _____ Twp. _____ R. _____

#1 Taylor

Well No. _____ Farm _____

Honaker Drlg.

Company _____

Honaker Drlg.

Contractor _____

Saundra Pool


330 Ft. from N. Line

_____ Ft. from S. Line

_____ Ft. from E. Line

990 Ft. from W. Line

NE NW NE

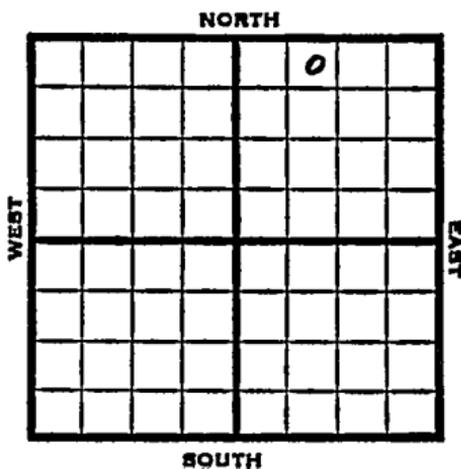

1953

1840'

REPORT

8/12

Spud 8-8-53

8" @ 235'

Drlg. 1750'

12/16

NR

12/22

Spud 8-8-53

Oil Well

TD 3616'

8" @ 235'

Heeb 3093, Br. Lime 3232, Lans 3242'

DST 3267'-86' opn 1 hr, rec 240' Oil 880#

DST 3300'-30' opn 1 hr, rec 55' wtr 775#

DST 3360'-78' opn 3/4 hr, rec 8' Mud Off.

DST 3416'-60' opn 1 hr, rec 160' sw

Arb 3555'

DST 3556'-67'

DST 3570'-90' opn 3/4 hr, rec 15' ocm Off

DST 3594'-3616' opn 1 hr, rec 120' ocm 5" @ 3616'

CO to 3408

9/ 3266-69 1/2 250 A S/ 8 boph 6 hr.

Comp 14 bopd.

COMPLETED

