


Section 22 Township 21 Range 12-W

Well No. #3 Taylor

Company Virginia Drlg.

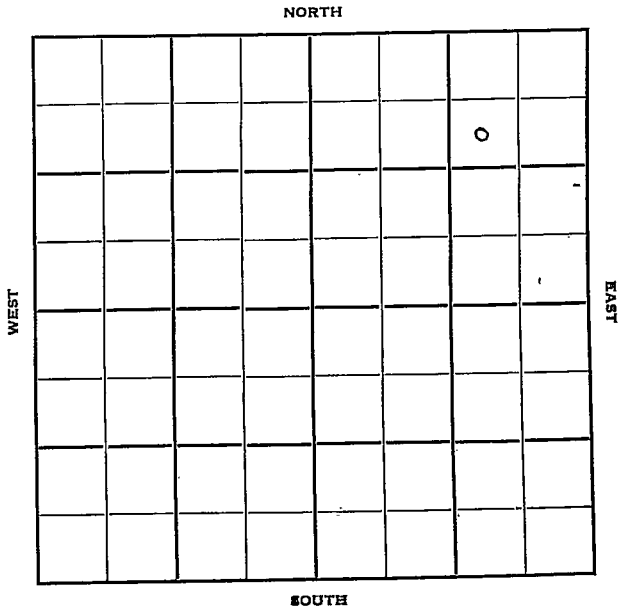

Stafford

KANSAS

Sec. 22 Twp. 21 R. 12W

Well No. #3 Taylor Farm

Virginia Drlg. Company

Contractor

Cundra


990' Ft. from N. Line

Ft. from S. Line

990' Ft. from E. Line

Ft. from W. Line

SW NE NE

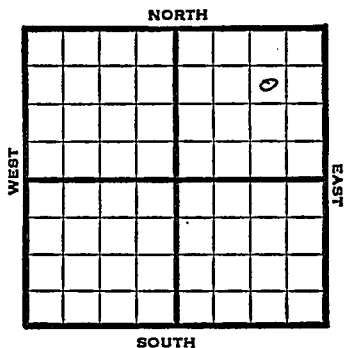

1950

Elev. 1844' REPORT

5/24

Spud 5-12-50
8-5/8" @ 298'
Anhy 645-65
Lans. 3236'
Drlg. 3487'

9/13

Spud 5-12-50
Oil Well TD 3591'
8-5/8" @ 298'
Anhy 645-65' Simp 3514'
Lans. 3236' Cong. 3476'
Viola 3489' Arb. 3562-67
5" @ 3564' TD 3571'
50 A 7 go 24 hr.
550 A DD 3580'
1000 A FU 300' fluid 80% wtr.
DD 3591' PB 3550'
24/3282-89 F/40 BOPH
1000 A F/33 BOPH
F/250 BO 4 hr. Comp. E/778 BOPD

COMPLETED

Map No. _____ Sec. 22 Twp. 21 R. 12WWell No. 3 TaylorVirginia Drlg. Company_____
SW NE NE Contractor

SECTION PLAT

990 Ft. from N. Line

_____ Ft. from S. Line

990 Ft. from E. Line

_____ Ft. from W. Line

			0
FIRST REPORT			

Stafford

Location _____

Rig up _____

Drilling and Remarks:

Spud 5-12-50

8 5/8" @ 298

Anhy 645-65

Lans. 3236

Drlg. 3487

RECORD

Cased _____ in., _____ ft.

Sand _____

Gas _____

Oil _____

Total Depth _____

PRODUCTION

1st 24 hrs. Nat. _____

1st 24 hrs. after shot _____

Gas _____ Cu. Ft.

Dry Hole _____

Abandoned _____

Date

MAY 24 1950

J. E. TYRA Scout

SECTION 1

MAY 26 1950

- Scout Cards
- Land Small Map
- Land Wall Map
- Tracings
- France Map
- Pierce Map
- Misc.

SEP 19 1950

~~Scout Cards~~
~~Land Small Maps~~
~~Land Wall Map~~
~~Tracing~~
~~France Map~~
~~Pierce Map~~
~~Misc.~~