


Section 22 Township 21 Range 12-W

Well No. #1 Taylor

Company Virginia Drlg.

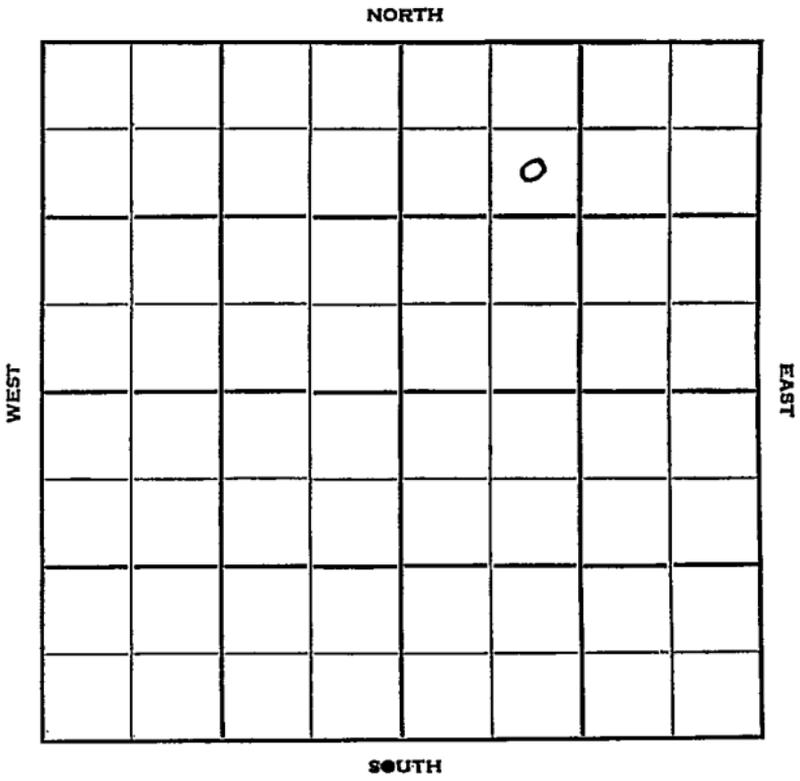

Sec. 22 Twp. 21 R. 12W

Well No. #4 Taylor Farm

Virginia Drig. Company

Contractor

Saundra Pool


990' Ft. from N. Line

\_\_\_\_\_ Ft. from S. Line

\_\_\_\_\_ Ft. from E. Line

990' Ft. from W. Line

SE NW NE

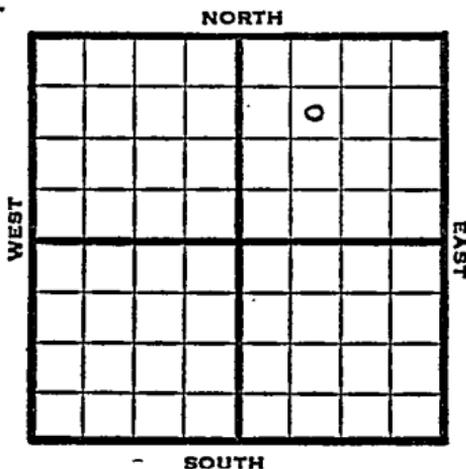

1950 Elev 1841' REPORT

11/15 Spud 11-11-50  
8" @ 348'  
Drlg. 680'

1951  
1/17 Spud 11-11-50  
8" @ 348  
Cong. 3470  
Simp 3511  
5" @ 3566  
TD 3581  
Hydrafrac  
SP 3400  
12/3316-20  
500 A  
Test water  
D&A TD 3581  
**ABANDONED**

Viola 3491  
Arb 3564-67

County Stafford State Kansas

Sec. 22 (Blk. Twp.) 21 (Sur. Rge.) 12W Map No.

Operator Virginia Drlg.

Well No. 4 Farm Taylor

Elev. \_\_\_\_\_ Location SE NW NE

			0		
FIRST REPORT					

990 Ft. From N Line NE

990 Ft. From W Line Quarter

1st. Report NOV 15 1950

Completion \_\_\_\_\_

Remarks \_\_\_\_\_

Spudding Date 11-11-50

Drlg. Data Saundra Pool

8" @ 348 drlg. 680

NOV 17 1953

Scout Cards	.....
Land Small Map	.....
Land Wall Map	.....
Tracing	.....
France Map	.....
Pierce Map	.....
Misc.	.....

*D.S.*

3



JAN 23 1951

Scout Cards	7
Land C	1
Land	1
Tracings	
France Map	
Pierce Map	
Misc.	

Orig. Data